

Hancock
 B 2028
 5/23/80

MISSISSIPPI
 BOARD OF WATER COMMISSIONERS
 416 North State Street
 Jackson, Mississippi 39201

WATER WELL DRILLERS LOG

12-20 date well completed
 80 Pouncey Water Well firm name
 Hancock county well located

LANDOWNER: Don Russin -
 Rt 3.
 Perkinston -
 (mailing address)

WELL LOCATION:
 sec. 27 T 5 N R 14 E
 4 miles W of Decise
 (distance) (direction) (nearest town)

WELL PURPOSE: Home -
 (home, irrigation, municipal, industrial)

WELL COMPLETION DATA:
 (1) diameter (inches) 2
 (2) total depth (feet) 432
 (3) static water level (feet) 82 below top of ground
 (4) casing PVC TD -
 2 (size) if telescope see back.
 (5) screen 10 432
 (length) (depth to top)
 2 PVC
 (size) (material)
 (6) pump 1 8
 (HP) (yield gpm)
 AC 220 -
 (type power)
 (7) electric log (yes or no)
 (organization running log)
 (8) how well bottom plugged Sealed

description of formations encountered	from	to
Top - clay -	0	20
Jank - silt.	20	60
Clay Jank -	60	230
Clay - c silt.	230	300
silt.	300	390
sd - fine fine.	390	416
Hard sd - Bottom -	416	432

DEPT. OF NATURAL RESOURCES
 BUREAU OF LAND & WATER RESOURCES


MAY 19 1980

RECEIVED

DRILLERS REMARKS:

If well telescopes please sketch and show depths.

GROUND LEVEL

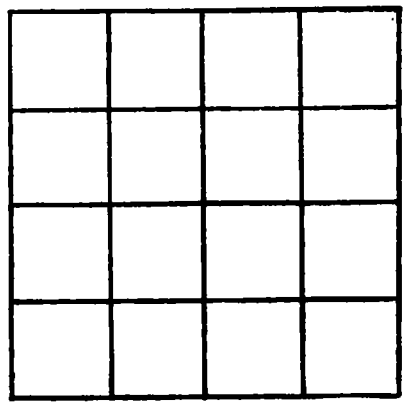

SECTION _____

Please indicate well location X.

ADDITIONAL INFORMATION

A series of horizontal lines for providing additional information, located below the 'ADDITIONAL INFORMATION' header.

If more than one screen, show locations of each on sketch.