

Hancock  
 B 2099  
 5/23/80

MISSISSIPPI  
 BOARD OF WATER COMMISSIONERS  
 416 North State Street  
 Jackson, Mississippi 39201

WATER WELL DRILLERS LOG

12-11-1980 UNCEY WATER WELL DRILLING Hancock -  
 date well completed firm name county well located

LANDOWNER: Bill Wellon  
Rt. 2  
Peeking Str.  
 (mailing address)

description of formations encountered	from	to
Top - Clay -	0	40
Silt. Snd.	40	68
clay -	68	240
silt out - sd.	240	290
Clay silt.	290	320
Sd.	320	400
Bigat P-gravel.	375	400

WELL LOCATION:  
 sec. 30 T 5 N R 14 E  
4 miles (S) of (W) WACHISG. CROSSING  
 (distance) (direction) (nearest town)

WELL PURPOSE: Home - (2)  
 (home, irrigation, municipal, industrial)


- WELL COMPLETION DATA:
- (1) diameter (inches) 4 x 2
  - (2) total depth (feet) 400
  - (3) static water level (feet) 50 below top of ground.
  - (4) casing PVC 390  
 (material) (depth)  
 (size) If telescope see back.
  - (5) screen 10 390  
 (length) (depth to top)  
2 PVC wrap  
 (size) (material)
  - (6) pump 3/4 12  
 (HP) (yield gpm)  
AC - 220V  
 (type power)
  - (7) electric log             
 (yes or no)  
 (organization running log)
  - (8) how well bottom plugged Scold

DRILLERS REMARKS: Head well -

DEPT. OF NATURAL RESOURCES  
 BUREAU OF WATER RESOURCES  
 MAY 19 1980  
**RECEIVED**

If well telescopes please sketch and show depths.

GROUND LEVEL

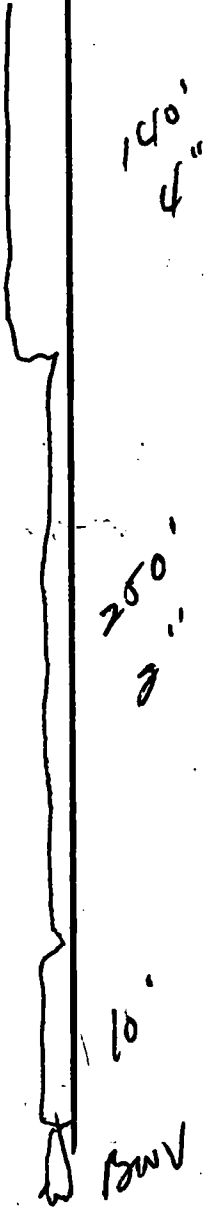

			X

SECTION \_\_\_\_\_

Please indicate well location X.

ADDITIONAL INFORMATION

If more than one screen, show locations of each on sketch.