

MISSISSIPPI DEPARTMENT OF NATURAL RESOURCES

Bureau of Land and Water Resources

Southport Mall

P.O. Box 10631

Jackson, Mississippi 39209

WATER WELL DRILLERS LOG

Hancock
B 2032
3/27/81

3/27/81
date well completed

Lyman Well Co
firm name

Hancock
county well located

LANDOWNER: Jane Randall
Rt 2 Box 192
Perkinston, 39573
(mailing address)


description of formations encountered	from	to
<u>yellow clay</u>	<u>0</u>	<u>30</u>
<u>yellow sand fine</u>	<u>30</u>	<u>110</u>
<u>blue clay</u>	<u>110</u>	<u>220</u>
<u>sand</u>	<u>220</u>	<u>284</u>

WELL LOCATION:
sec. 20 T. 5 N. R. 14 E.
30 miles SE of Topiwah
(distance) (direction) (nearest town)

WELL PURPOSE: Home
(home, irrigation, municipal, industrial)

WELL COMPLETION DATA:

- (1) diameter (inches) 4"
- (2) total depth (feet) 284'
- (3) static water level (feet) 115 below top of ground.
- (4) casing PVC 284'
(material) (depth)
4"
(size) If telescope see back.
- (5) screen 10' 284'
(length) (depth to top)
4" PVC
(size) (material)
- (6) pump 1/2
(HP) (yield gpm)
electric
(type power)
- (7) electric log No
(yes or no)
No
(organization running log)
- (8) how well bottom plugged sand
Shark

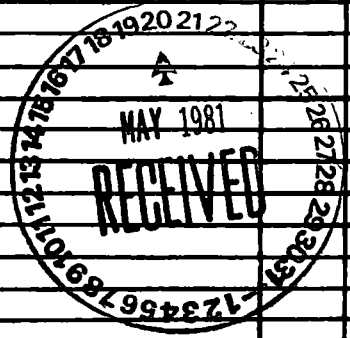

DEPT. OF NATURAL RESOURCES
BUREAU OF LAND & WATER RESOURCES

MAY 20 1981

RECEIVED

DRILLERS REMARKS: Water
It's A lot of FROW IN IT

If well telescopes please sketch and show depths.

GROUND LEVEL

		X	05

SECTION _____

Please indicate well location X.

ADDITIONAL INFORMATION

DEPT. OF NATURAL RESOURCES
MINISTRY OF ENERGY AND TRANSPORTATION

If more than one screen,
show locations of each on sketch.