

MISSISSIPPI DEPARTMENT OF NATURAL RESOURCES

Bureau of Land and Water Resources

Southport Mall

P.O. Box 10631

Jackson, Mississippi 39209

HANCOCK
B 2036
8-6-81
8-6-81

WATER WELL DRILLERS LOG
BRADEN PUMP AND WELL SERVICE, INC.
ROUTE 1, BOX 489

SAUCIER, MS # 39574

HANCOCK
county well located

date well completed 19

LANDOWNER:
HARNER FARMS
Rt 4, Box 271
Poplarville
(mailing address)


description of formations encountered	from	to
CLAY	0	20
SAND	20	25
CLAY	25	85
SAND + CLAY	85	100
SAND	100	120

WELL LOCATION:
sec. 5 T. 5 N. R. 14 E.
3 miles ~~SW~~ N of Decatur
(distance) (direction) (nearest town)

WELL PURPOSE: none
(home, irrigation, municipal, industrial)

- WELL COMPLETION DATA:
- (1) diameter (inches) 2"
 - (2) total depth (feet) 120
 - (3) static water level (feet) 40 below above top of ground.
 - (4) casing Pvc total (material), (depth)
2" (size) If telescope see back.
 - (5) screen 10 (length), 110 (depth to top)
2" (size), Pvc underdrain (material)
 - (6) pump 1 (HP), 8 (yield gpm)
110 (type power)
 - (7) electric log NO (yes or no)
(organization running log)
 - (8) how well bottom plugged
2" SAND SHARK

DRILLERS REMARKS:
NO tail pipe

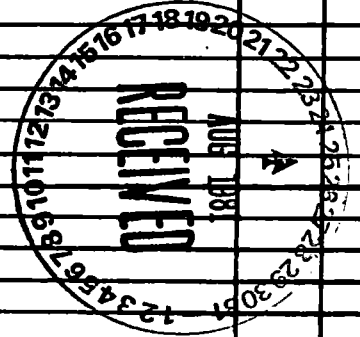

DEPT. OF NATURAL RESOURCES
BUREAU OF LAND & WATER RESOURCES

AUG 25 1981

RECEIVED

