

MISSISSIPPI DEPARTMENT OF NATURAL RESOURCES

Bureau of Land and Water Resources

Southport Mall

P.O. Box 10631

Jackson, Mississippi 39209

WATER WELL DRILLERS LOG

Hancock
B 9049

1-29-85 19 Gulf Coast Water Well HANCOCK
date well completed firm name county well located

LANDOWNER: MORRIS LANDBRUM

description of formations encountered

from to

RT 2 Box 194 A

PERKINSTON MS
(mailing address)

WELL LOCATION:

sec 9 T 5 R 14 S W
12 miles North of MILN
(distance) (direction) (nearest town)

<u>CLAY</u>	<u>0</u>	<u>20</u>
<u>SANDY CLAY red</u>	<u>20</u>	<u>70</u>
<u>White CLAY</u>	<u>70</u>	<u>95</u>
<u>SANDY CLAY</u>	<u>85</u>	<u>115</u>
<u>Hard CLAY</u>	<u>115</u>	<u>130</u>
<u>Muddy Sand</u>	<u>130</u>	<u>170</u>
<u>CLAY - Sand</u>	<u>170</u>	<u>200</u>
<u>Clean med sand</u>	<u>200</u>	<u>247</u>

WELL PURPOSE: Home
(home, Irrigation, municipal, Industrial)

WELL COMPLETION DATA:

- (1) diameter (Inches) 2"
- (2) total depth (feet) 257
- (3) static water level (feet) 91 below top of ground.
- (4) casing PVC 247
(material) (depth)
- 2" if telescope see back.
(size)
- (5) screen 10' 247
(length) (depth to top)
- 2" PVC
(size) (material)
- (6) pump 1 1/2 8
(HP) (yield gpm)
- 230 V
(type power)
- (7) electric log NO
(yes or no)

(organization running log)

(8) how well bottom plugged SAND SAND
PVC


DRILLERS REMARKS:

RECEIVED
FEB 9 1985

Department of Natural Resources
Bureau of Land & Water

If well telescopes please sketch and show depths.

GROUND LEVEL

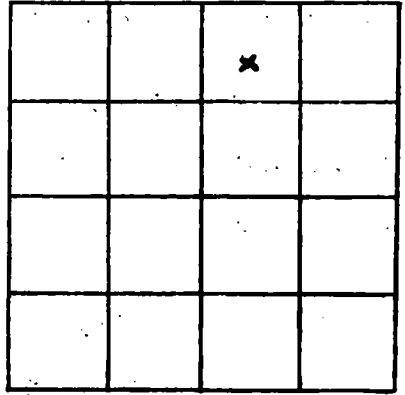

SECTION 29

Please indicate well location X.

ADDITIONAL INFORMATION

If more than one screen, show locations of each on sketch.