

MISSISSIPPI DEPARTMENT OF NATURAL RESOURCES

Bureau of Land and Water Resources

Southport Mall

P.O. Box 10631

Jackson, Mississippi 39209

WATER WELL DRILLERS LOG

Hancock
B 2054

3-10-86
date well completed

POUNCEY WATER WELL DRILLING
firm name

Hancock
county well located

LANDOWNER: Tom Curran
119 603

(mailing address)

WELL LOCATION:

sec. 28 T. 5 N. R. 14 E. CS
3 miles S of Nacogdoches
(distance) (direction) (nearest town)

WELL PURPOSE:

(home, irrigation, municipal, industrial)

WELL COMPLETION DATA:

- (1) diameter (inches) 4X2
- (2) total depth (feet) 272
- (3) static water level (feet) 98' below top of ground
- (4) casing PVC 257
(material) (depth)
(size) If telescope see back.
- (5) screen 15 257
(length) (depth to top)
2 PVC
(size) (material)
- (6) pump 1 1/2 24
(HP) (yield gpm)
AC
(type power)
- (7) electric log (yes or no)
- (8) how well bottom plugged Sealed

description of formations encountered

from to

TOP	0	38
fine brown clay	38	78
st	78	236
	236	246
sd good tight	246	272
like green cement.		


RECEIVED
MAR 25 1986

DRILLERS REMARKS:

Department of Natural Resources
Bureau of Land & Water Resources

If well telescopes please sketch and show depths.

GROUND LEVEL

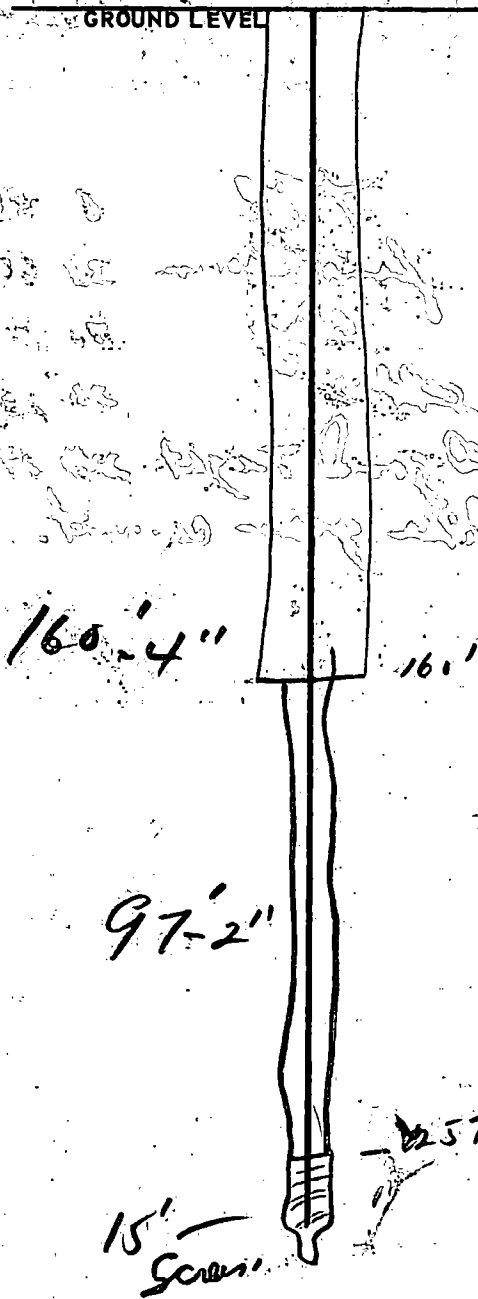

*			

SECTION 28

Please indicate well location X.

ADDITIONAL INFORMATION

If more than one screen, show locations of each on sketch.