

MISSISSIPPI DEPARTMENT OF NATURAL RESOURCES

Bureau of Land and Water Resources

Southport Mall

P.O. Box 10631

Jackson, Mississippi 39209

WATER WELL DRILLERS LOG

Hancock
B 2258

12/11 1987 date well completed Best Peston firm name Worth county well located
Water Well Service

LANDOWNER: Eric McDonald
RT. 3 Box 356
Picayune Miss.
(mailing address)

description of formations encountered	from	to
<u>Red shale</u>	<u>0</u>	<u>20</u>
<u>Red sand</u>	<u>20</u>	<u>27</u>
<u>Blue shale</u>	<u>27</u>	<u>210</u>
<u>Blue sand</u>	<u>30</u>	<u>65</u>
<u>Blue shale</u>	<u>65</u>	<u>435</u>
<u>Gray sand</u>	<u>435</u>	<u>483</u>

WELL LOCATION:
sec. 19 T 5 N R. 14 E
S W
1 1/4 miles East of Carrier
(distance) (direction) (nearest town)

WELL PURPOSE: Home
(home, irrigation, municipal, industrial)

WELL COMPLETION DATA:

(1) diameter (inches) 4 1/2

(2) total depth (feet) 483

(3) static water level (feet) 155 below top of ground.

(4) casing plc 483
(material) (depth)
(size) If telescope see back.

(5) screen 10 475
(length) (depth to top)
12 plc
(size) (material)

(6) pump 1 18
(HP) (yield gpm)
(type power)

(7) electric log no
(yes or no)
(organization running log)

(8) how well bottom plugged by sand
shark

RECEIVED

APR 14 1988


Department of Natural Resources
Bureau of Land & Water Resources

DRILLERS REMARKS:

If well telescopes please sketch and show depths.

GROUND LEVEL

← 303 ft 2" →
← 180 ft 4" →

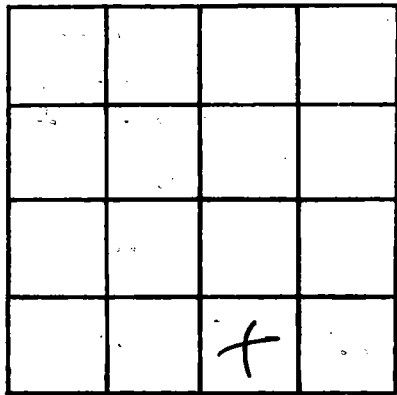

SECTION _____

Please indicate well location X.

ADDITIONAL INFORMATION

If more than one screen, show locations of each on sketch.