

MISSISSIPPI DEPARTMENT OF NATURAL RESOURCES
Bureau of Land and Water Resources
 Southport Mall
 P.O. Box 10631
 Jackson, Mississippi 39209
WATER WELL DRILLERS LOG

C 916
HANCOCK
2-4-85


Feb. 4 1985 Wood Well Drg. Hancock
 date well completed firm name county well located

LANDOWNER: W. E. Burk
General Delivery
Reidlington, ms.
 (mailing address)
 WELL LOCATION:
 sec. 19 T. 6 N. R. 16 E.
 (distance) miles (direction) of Reidlington (nearest town)

description of formations encountered	from	to
<u>Clay</u>	<u>0</u>	<u>18</u>
<u>Clay</u>	<u>18</u>	<u>34</u>
<u>Clay</u>	<u>34</u>	<u>48</u>
<u>Red Shovel - level</u>	<u>48</u>	<u>56</u>
<u>SD - Red Shovel</u>	<u>56</u>	<u>68</u>
<u>Clay</u>	<u>68</u>	<u>96</u>
<u>SD</u>	<u>96</u>	<u>120</u>

WELL PURPOSE: None
 (home, irrigation, municipal, industrial)

WELL COMPLETION DATA:
 (1) diameter (inches) 2"
 (2) total depth (feet) 120
 (3) static water level (feet) 8 ^{below} top of ground.
 (4) casing PVC 110
 (material) (depth)
 (size) if telescope see back.
 (5) screen 10' -
 (length) (depth to top)
2" PVC
 (size) (material)
 (6) pump 1/2 10
 (HP) (yield gpm)
Elec.
 (type power)
 (7) electric log NO
 (yes or no)
N/A
 (organization running log)
 (8) how well bottom plugged BWV

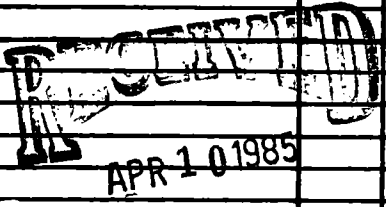

Department of Natural Resources
 Bureau of Land & Water Resources

DRILLERS REMARKS: N/A

If well telescopes please sketch and show depths.

GROUND LEVEL

		X	

SECTION 19

Please indicate well location X.

ADDITIONAL INFORMATION

If more than one screen,
show locations of each on sketch.