

C

12-15-60

WATER WELL DRILLERS LOG

X-300

Date: 12-15, 1960, Driller: Quirk & Davis county P. R.

(Name)

(1) Owner of Land: Joe Westbrook (Name) Pecayune Miss. (Address)

(2) Location: 1/4, 1/4, Sec. T R, 1.0 miles east of Pecayune (distance) (direction) (Nearest Town)

(3) Topography: (Hilly) (Flat) (Level)

(4) Purpose of Well: Domestic (Domestic Irrigation, Municipal, Industrial, Other)

Description & Color of Materials Sand, Clay, Red Clay, Shell, etc.	Thick- ness Feet	Depth Feet
Surface Sand	0	60
Blue Clay	60	170
grey Sand	170	202

Information upon completion of well:

(1) Diameter 2 inches.

(2) Total Depth 202 feet.

(3) Water Level 26 feet below top of ground.

(4) Cased to, Size

(5) Screen: Size 2, Length 5


(6) Were any formations sealed against pollution?

yes, no

If YES depth of formation

Why

Drillers Remarks: Good Well

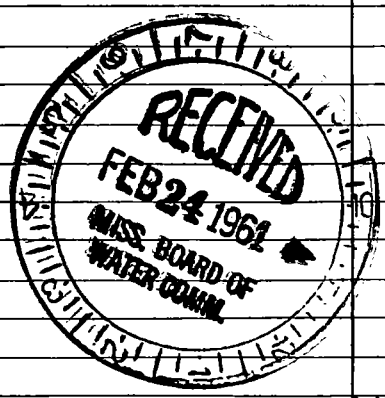

(Use Back Side)

Well No.