

CODED

Hancock
C5
10-7-68

MISSISSIPPI
BOARD OF WATER COMMISSIONERS
416 North State Street
Jackson, Mississippi 39201

WATER WELL DRILLERS LOG

10-7 1968 Penton Well Serv Hancock
date well completed firm name county well located

LANDOWNER: William Thiiphen
Rt. 3 Box 291
Pocayune MISS.
(mailing address)

description of formations encountered	From	To
Surface Clay	0	24
Red Sand	24	76
White Clay	76	120
Blue Clay	120	180
Grey Sand	180	204

WELL LOCATION:
sec. 9 T. 6 S. R. 15 W.
9 miles N.E. of Pocayune
(distance) (direction) (nearest town)

WELL PURPOSE: HOME
(home, irrigation, municipal, industrial)

WELL COMPLETION DATA: 4 1/2 Drilled

- (1) diameter (inches) 2"
- (2) total depth (feet) 204'
- (3) static water level (feet) 53 below top of ground
- (4) casing Galv. 199 (material) (depth)
2" (size) If telescope see back.
- (5) screen 5' 199 (length) (depth to top)
2" S. steel (size) (material)
- (6) pump 1 (HP) 11 (yield gpm)
Eloc (type power)
- (7) electric log NO (yes or no)
(organization running log)
- (8) how well bottom plugged B.W. Valve

CODED


OCT 16 1968

MISS. BD. OF
WATER COMMISSIONERS

DRILLERS REMARKS:

If well telescopes please sketch and show depths.

GROUND LEVEL

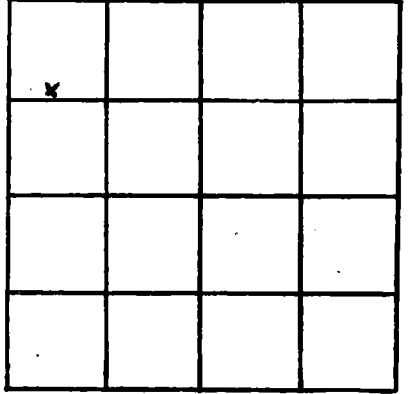

SECTION 9

Please indicate well location X.

ADDITIONAL INFORMATION

If more than one screen,
show locations of each on sketch.