

**MISSISSIPPI
BOARD OF WATER COMMISSIONERS**
416 North State Street
Jackson, Mississippi 39201

CODED

WATER WELL DRILLERS LOG

Hancock
C 6
10-17-68

10-17 1968 Penton Well Serv Hancock
date well completed firm name county well located

LANDOWNER: abn T. Nowkirk
P.O. 3 Box 910
Picayune Miss
(mailing address)

description of formations encountered	From	To
<u>Clay</u>	<u>0</u>	<u>19</u>
<u>Red Sand</u>	<u>19</u>	<u>48</u>
<u>White Clay</u>	<u>48</u>	<u>65</u>
<u>Black Clay</u>	<u>65</u>	<u>78</u>
<u>Blue Clay</u>	<u>78</u>	<u>336</u>
<u>Grey Sand</u>	<u>336</u>	<u>387</u>

WELL LOCATION:
sec. 34 T. 6 S. R. 15 W.
5 1/2 miles NW of Kiln
(distance) (direction) (nearest town)


WELL PURPOSE: Home
(home, irrigation, municipal, industrial)

WELL COMPLETION DATA: 4 1/2 Drilled

- (1) diameter (inches) 2"
- (2) total depth (feet) 387
- (3) static water level (feet) 13 below top of ground.
- (4) casing Galv Steel 382'
(material) (depth)
2" if telescope see back.
(size)
- (5) screen 5' 382'
(length) (depth to top)
2" S. Steel
(size) (material)
- (6) pump 1 12
(HP) (yield gpm)
Elec
(type power)
- (7) electric log NO
(yes or no)
(organization running log)
- (8) how well bottom plugged Bw. Valve

CODED

1012

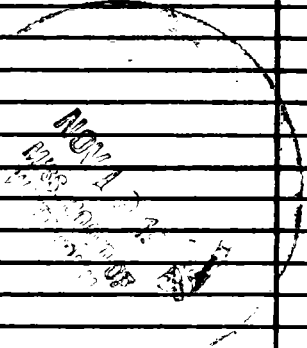

DRILLERS REMARKS:

If well telescopes please sketch and show depths.

GROUND LEVEL

X			

SECTION 34

Please indicate well location X.

ADDITIONAL INFORMATION

If more than one screen, show locations of each on sketch.