

MISSISSIPPI
BOARD OF WATER COMMISSIONERS
416 North State Street
Jackson, Mississippi 39201

CODED

WATER WELL DRILLERS LOG

NEIL LUMPKIN WELL DRILLING SERVICE
P. O. BOX 117

MEMPHIS, MISS.

county well located

HANCOCK
C 8
5/19/69

5-19 1969
date well completed

Hancock

LANDOWNER: Lamar J. Lee
Picayune, Route 1
(mailing address)

description of formations encountered	from	to
Surface Clay	0	20
" sand	20	120
Blue Clay + sand - streaks	120	500
Good sands fine to better	500	561

WELL LOCATION:
sec. 28 T. 6 N. R. 16 E.
8 miles East of Picayune
(distance) (direction) (nearest town)

WELL PURPOSE: home
(home, irrigation, municipal, industrial)

- WELL COMPLETION DATA:
- (1) diameter (inches) 2"
 - (2) total depth (feet) 561'
 - (3) static water level (feet) flow below above top of ground.
 - (4) casing galv. (material), (depth)
2" (size) If telescope see back.
 - (5) screen 5' (length), (depth to top)
2" (size), St. Steel (material)
 - (6) pump 1/2 (HP), 500 per hr. (yield gpm)
electric (type power)
 - (7) electric log No! (yes or no)
- (organization running log)

(8) how well bottom plugged Back pressure valve


DRILLERS REMARKS:

JUL 14 1969

MISS. BD. OF
WATER COM. &

If well telescopes please sketch and show depths.

GROUND LEVEL

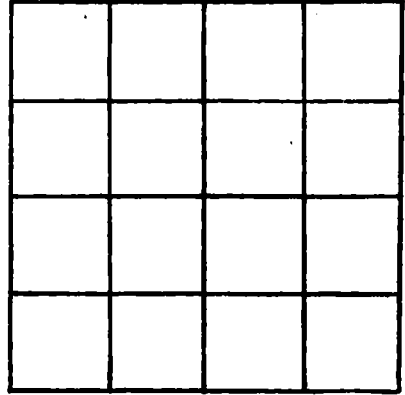

SECTION _____

Please indicate well location X.

ADDITIONAL INFORMATION

If more than one screen, show locations of each on sketch.