

Hancock  
C 13  
12-16-69

MISSISSIPPI  
 BOARD OF WATER COMMISSIONERS  
 416 North State Street  
 Jackson, Mississippi 39201

CODED

CODED

WATER WELL DRILLERS LOG

12-16 1969 Penton Well Serv Hancock  
 date well completed firm name county well located

| LANDOWNER: <u>Dale Whitfield</u>          | description of formations encountered | from       | to         |
|---|---------------------------------------|------------|------------|
| <u>Rt. 3 Box 347</u>                      |                                       |            |            |
| <u>Picayune Miss</u><br>(mailing address) | <u>Red Clay</u>                       | <u>0</u>   | <u>36</u>  |
|   | <u>Red Sand</u>                       | <u>36</u>  | <u>147</u> |
|   | <u>Blue Clay</u>                      | <u>147</u> | <u>290</u> |
|   | <u>Grey Sand</u>                      | <u>290</u> | <u>337</u> |

WELL LOCATION:  
 sec. 21 T. 6 S. R. 15 W.  
7 miles NW of Kelso  
 (distance) (direction) (nearest town)

WELL PURPOSE: Home  
 (home, irrigation, municipal, industrial)

- WELL COMPLETION DATA:
- (1) diameter (inches) 2
  - (2) total depth (feet) 337
  - (3) static water level (feet) 19 below top of ground.
  - (4) casing Cslu 332,  
 (material) (depth)  
2 if telescope see back.  
 (size)
  - (5) screen 5 332  
 (length) (depth to top)  
2" St. Steel  
 (size) (material)
  - (6) pump 1/2 900  
 (HP) (yield gpm)  
Elec  
 (type power)
  - (7) electric log NO  
 (yes or no)
- (organization running log)
- (8) how well bottom plugged BW. Valve

JAN 12 1970


MISS. BD. OF  
 WATER COMM.

DRILLERS REMARKS: S:

012

If well telescopes please sketch and show depths.

GROUND LEVEL

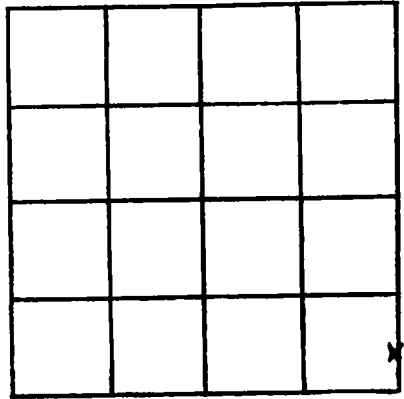

SECTION 21

Please indicate well location X.

ADDITIONAL INFORMATION

If more than one screen, show locations of each on sketch.