

Hancock
 C. 15
 2-11-70

MISSISSIPPI
 BOARD OF WATER COMMISSIONERS
 416 North State Street
 Jackson, Mississippi 39201

CODED

WATER WELL DRILLERS LOG

2-11-70 date well completed 1970 Penton Well Serv firm name Hancock county well located

LANDOWNER: W. D. MOONEY
Rt. 1 Box 267 B
Picayune Miss
 (mailing address)

description of formations encountered	from	to
Red clay	0	20
Sand	20	68
yellow clay	68	83
Black clay	83	95
Blue clay	95	208
Mud	208	216
Blue clay	216	465
Grey sand	465	515

WELL LOCATION:
 sec. 23 T. 6 S. R. 16 W.
5 miles East of Picayune
 (distance) (direction) (nearest town)

WELL PURPOSE: Home
 (home, irrigation, municipal, industrial)

WELL COMPLETION DATA: 4 1/2

(1) diameter (inches) 2"

(2) total depth (feet) 515

(3) static water level (feet) 3 below top of ground.

(4) casing Galv, \$85,
 (material) (depth)
2" if telescope see back.
 (size)

(5) screen 10, 505
 (length) (depth to top)

012 2", S. Steel
 (size) (material)

(6) pump ✓ ✓
 (HP) (yield gpm)
✓
 (type power)

(7) electric log NO
 (yes or no)

(organization running log)

(8) how well bottom plugged BD Value


FEB 25 1970

MISS. BD. OF
 WATER COMM.

DRILLERS REMARKS: _____

If well telescopes please sketch and show depths.

GROUND LEVEL

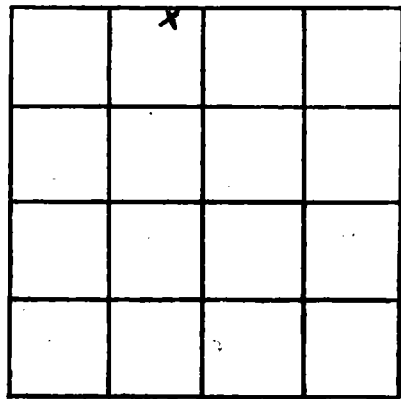

SECTION 23

Please indicate well location X.

ADDITIONAL INFORMATION

If more than one screen, show locations of each on sketch.