

Hancock
C 17
1-31-70

MISSISSIPPI
BOARD OF WATER COMMISSIONERS
416 North State Street
Jackson, Mississippi 39201

CODED

WATER WELL DRILLERS LOG

1-31 1970 Pantan Well Serv Hancock
date well completed firm name county well located

LANDOWNER: Joe Milton
Rt 3 Box 310
Picayune Miss
(mailing address)

WELL LOCATION:
sec. 34 T 6 R 15
6 miles North of Kiln
(distance) (direction) (nearest town)

WELL PURPOSE: Home
(home, irrigation, municipal, industrial)

WELL COMPLETION DATA:
(1) diameter (inches) 2
(2) total depth (feet) 390
(3) static water level (feet) Flow above top of ground.
(4) casing Galv 385 (material) (depth)
2" (size) if telescope see back.
(5) screen 5' 385 (length) (depth to top)
2" S. Steel (size) (material)
(6) pump (HP) (yield gpm)
(type power)
(7) electric log No (yes or no)
(organization running log)
(8) how well bottom plugged BU Valve

| description of formations encountered | from | to |
|---------------------------------------|------|-----|
| Surface Clay | 0 | 23 |
| Sand | 23 | 68 |
| White Clay | 68 | 95 |
| Blue Clay | 95 | 165 |
| Mud | 165 | 182 |
| Blue Clay | 182 | 245 |
| Fine Sand | 245 | 272 |
| Blue Clay | 272 | 338 |
| Grey Sand | 338 | 390 |

CODED

MAR 2 - 1970

MISS. BD. OF
WATER COM.

DRILLERS REMARKS:

If well telescopes please sketch and show depths.


D33

B 10-

E

O 33

GROUND LEVEL

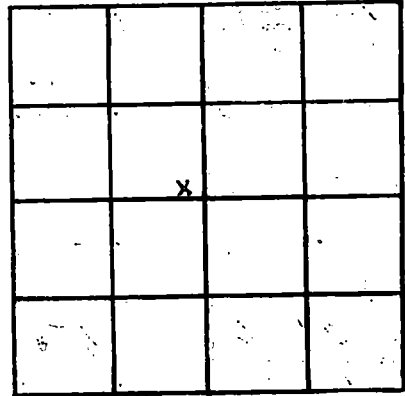

SECTION 34

Please indicate well location X.

ADDITIONAL INFORMATION

If more than one screen,
show locations of each on sketch.