

Hancock  
C 23  
6-4-70

MISSISSIPPI  
 BOARD OF WATER COMMISSIONERS  
 416 North State Street  
 Jackson, Mississippi 39201

**CODED**

WATER WELL DRILLERS LOG

6-4 1970 Penken Well serv Hancock  
 date well completed firm name county well located

LANDOWNER: J. D. Soloume  
Pt. 3 Box 157  
Slide 11 La.  
 (mailing address)

description of formations encountered	from	to
Surface clay	0	24
Red sand	24	65
White clay	65	80
Blue clay	80	217
Fine sand	217	332
Blue clay	330	345
Grey sand	345	380

WELL LOCATION:  
 sec. 39 T. 6 R. 15  
6 miles NW of Kilal  
 (distance) (direction) (nearest town)

WELL PURPOSE: Home  
 (home, irrigation, municipal, industrial)

- WELL COMPLETION DATA:
- (1) diameter (inches) 2
  - (2) total depth (feet) 380
  - (3) static water level (feet) 16 below top of ground.
  - (4) casing 6x4, 375,  
 (material) (depth)  
2" if telescope see back.  
 (size)
  - (5) screen 5, 375  
 (length) (depth to top)  
2", S. Steel  
 (size) (material)
  - (6) pump ✓ ✓  
 (HP) (yield gpm)  
 (type power)
  - (7) electric log NO  
 (yes or no)  
 (organization running log)
  - (8) how well bottom plugged B.W. Valve

**CODED**


JUN 23 1970

DRILLERS REMARKS:

MISC. NO. OF WATER

If well telescopes please sketch and show depths.

GROUND LEVEL

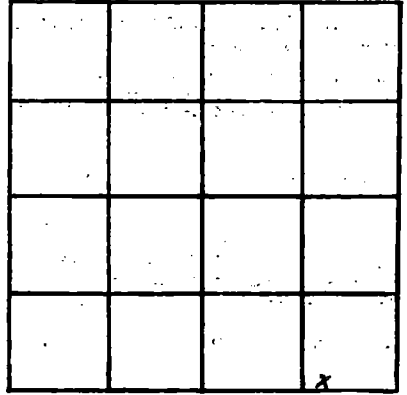

SECTION 29

Please indicate well location X.

ADDITIONAL INFORMATION

If more than one screen, show locations of each on sketch.