

Hancock
C 24
6-5-70

MISSISSIPPI
BOARD OF WATER COMMISSIONERS
416 North State Street
Jackson, Mississippi 39201

CODED

WATER WELL DRILLERS LOG

6-5-70 date well completed Penton Well serv firm name Hancock county well located

LANDOWNER: Johal Marx
Rt. 4 Box 470
Picayune MISS
(mailing address)

description of formations encountered	from	to
Surface clay	0	28
Sand	28	55
White Clay	55	80
Blue Clay	80	245
Grey Sand	245	275

WELL LOCATION:
sec 23 T 6 R 16
5 miles East of Picayune
(distance) (direction) (nearest town)

WELL PURPOSE: Home
(home, irrigation, municipal, industrial)

- WELL COMPLETION DATA:
- (1) diameter (inches) 2
 - (2) total depth (feet) 275
 - (3) static water level (feet) 25 below top of ground.
 - (4) casing Galv, 270,
(material) (depth)
2 if telescope see back.
(size)
 - (5) screen 5', 270
(length) (depth to top)
012 2", S. Steel
(size) (material)
 - (6) pump 1 12
(HP) (yield gpm)
Elec
(type power)
 - (7) electric log NO
(yes or no)
(organization running log)
 - (8) how well bottom plugged B.W. Value

CODED


JUL 10 1970

MISS. BD. OF
WATER COMM.

DRILLERS REMARKS:

If well telescopes please sketch and show depths.

GROUND LEVEL

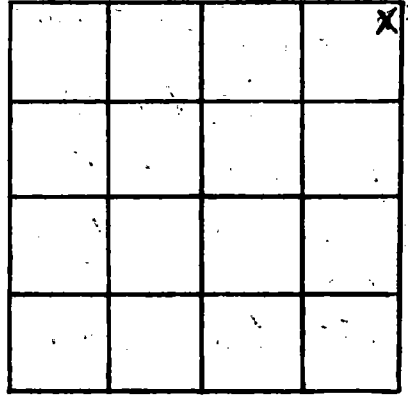

SECTION 23

Please indicate well location X.

ADDITIONAL INFORMATION

If more than one screen, show locations of each on sketch.