

HANCOCK  
C 26  
7-20-70

MISSISSIPPI  
BOARD OF WATER COMMISSIONERS  
416 North State Street  
Jackson, Mississippi 39201

**CODED**

WATER WELL DRILLERS LOG

7-20 1970 Penton Well Serv HANCOCK  
date well completed firm name county well located

LANDOWNER: Kenneth Seal  
Purvis, Miss  
(mailing address)

description of formations encountered	from	to
Surface clay	0	30
Red sand	30	93
White sand	93	138
Blue clay	138	196
Sand	196	216

WELL LOCATION:  
sec. 8 T. 6 N R. 15 W  
9 miles East of Rayane  
(distance) (direction) (nearest town)

WELL PURPOSE: Home  
(home, irrigation, municipal, industrial)

WELL COMPLETION DATA:

(1) diameter (inches) 2

(2) total depth (feet) 216

(3) static water level (feet) 40 below top of ground.

(4) casing Palu, 211,  
(material) (depth)  
2 if telescope see back.  
(size)

(5) screen 5, 211  
(length) (depth to top)

012 2", S. Steel  
(size) (material)

(6) pump 1 11  
(HP) (yield gpm)  
Elec  
(type power)

(7) electric log NO  
(yes or no)

(organization running log)

(8) how well bottom plugged BW Valve

**CODED**


AUG 27 1970

DRILLERS REMARKS:

MISS. BD. OF  
WATER COMM.

If well telescopes please sketch and show depths.

GROUND LEVEL

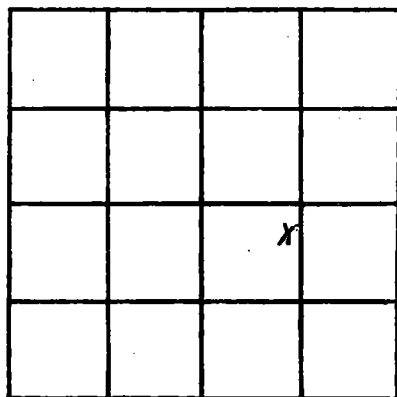

SECTION 8

Please indicate well location X.

ADDITIONAL INFORMATION

If more than one screen,  
show locations of each on sketch.