

HANCOCK
C 29
1-21-71

MISSISSIPPI
 BOARD OF WATER COMMISSIONERS
 416 North State Street
 Jackson, Mississippi 39201

CODED

WELL WELL DRILLERS LOG

1-21 1971 Porton Well Serv Hancock
 date well completed firm name county well located

LANDOWNER: Ezell Lee
101 Moody St
Picayune MISS
 (mailing address)

description of formations encountered	from	to
Surface Clay	0	25
Red Sand	25	83
White Clay	83	95
Blue Clay	95	407
Sand	407	442

WELL LOCATION:
 sec. 5 T. 6 S. R. 15 E. W.
3 miles East of Caesar
 (distance) (direction) (nearest town)

WELL PURPOSE: Home
 (home, irrigation, municipal, industrial)

WELL COMPLETION DATA:
 (1) diameter (inches) 2
 (2) total depth (feet) 442
 (3) static water level (feet) 67 below above top of ground.
 (4) casing Galv. 442
 (material) (depth)
2" if telescope see back.
 (size)
 (5) screen 5' 442
 (length) (depth to top)
2 S. Steel
 (size) (material)
 (6) pump 1 7
 (HP) (yield gpm)
Elec
 (type power)
 (7) electric log NO
 (yes or no)
 (organization running log)

CODED

(8) how well bottom plugged Bad Valve


FEB 1 1971

DRILLERS REMARKS:

MISS. BD. OF
 WATER COMM.

If well telescopes please sketch and show depths.


GROUND LEVEL

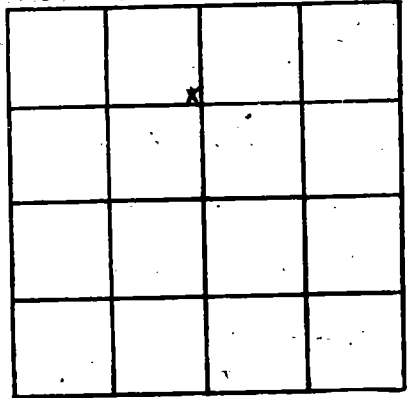

SECTION 5

Please indicate well location X.

ADDITIONAL INFORMATION

If more than one screen, show locations of each on sketch.