

HANCOCK
C 30
1-26-71

MISSISSIPPI
 BOARD OF WATER COMMISSIONERS
 416 North State Street
 Jackson, Mississippi 39201

WATER WELL DRILLERS LOG

CODED

1-26 1971 Penton Well Serv Hancock
 date well completed firm name county well located

LANDOWNER:	description of formations encountered	from	to
<u>Hays Martin</u>	<u>Surface clay</u>	<u>0</u>	<u>20</u>
<u>Rt. 1 Box 253</u>	<u>Sand</u>	<u>20</u>	<u>55</u>
<u>Picayune Miss</u>	<u>White clay</u>	<u>55</u>	<u>80</u>
(mailing address)	<u>Black clay</u>	<u>80</u>	<u>105</u>
WELL LOCATION:	<u>Mud</u>	<u>105</u>	<u>220</u>
sec. <u>23</u> T <u>6</u> S R. <u>16</u> W	<u>Blue clay</u>	<u>220</u>	<u>565</u>
<u>6</u> miles <u>East</u> of <u>Picayune</u>	<u>Fine sand</u>	<u>565</u>	<u>595</u>
(distance) (direction) (nearest town)	<u>Blue clay</u>	<u>595</u>	<u>670</u>
WELL PURPOSE: <u>Home</u>	<u>Fine sand</u>	<u>670</u>	<u>705</u>
(home, irrigation, municipal, industrial)	<u>Blue clay</u>	<u>705</u>	<u>780</u>
WELL COMPLETION DATA:	<u>Sand</u>	<u>780</u>	<u>808</u>
(1) diameter (inches) <u>2</u>			
(2) total depth (feet) <u>808</u>			
(3) static water level (feet) <u>1</u> below top of ground.			
(4) casing <u>Galv.</u> <u>798</u>			
(material) (depth)			
<u>2</u> If telescope see back.			
(size)			
(5) screen <u>10'</u> <u>798</u>			
(length) (depth to top)			
<u>.012</u> <u>2</u> <u>S. Steel</u>			
(size) (material)			
(6) pump <u>1/2</u> <u>14</u>			
(HP) (yield gpm)			
<u>Elec</u>			
(type power)			
(7) electric log <u>NO</u>			
(yes or no)			
(organization running log)			
(8) how well bottom plugged <u>B.W. Valve</u>			
DRILLERS REMARKS:			


CODED

FEB 1 1971

MISS. BD. OF WATER COM.

If well telescopes please sketch and show depths.

GROUND LEVEL

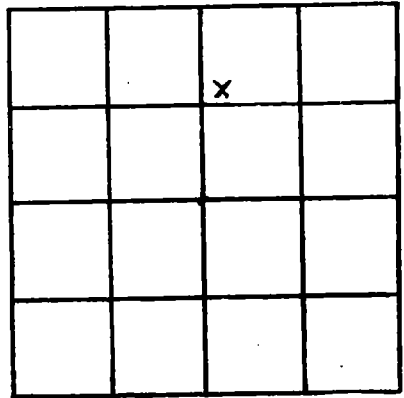

SECTION 23

Please indicate well location X.

ADDITIONAL INFORMATION

If more than one screen, show locations of each on sketch.