

DC-35

3-17-64

WATER WELL DRILLERS LOG

CODED

Date: 3-17, 1964, Driller: J. Beall County Hancock

(Name)

(1) Owner of Land: R.W. Dobb
 (Name)
Rt 1 Box 185-F Cross Christian
 (Address)

(2) Location: SE 1/4, NW 1/4, Sec 32 T6 R15
10 miles north, of Kilbr
 (distance) (direction) (Nearest Town)

(3) Topography: (Hilly) (Flat) (Level)

(4) Purpose of Well: Home
 (Domestic Irrigation
 Municipal, Industrial, Other)

| Description & Color of Materials Sand, Clay, Red Clay, Shell, etc. | Thick- ness Feet | Depth Feet |
|---|------------------------|---------------|
| <u>Hard white mud</u> | <u>30</u> | <u>30</u> |
| <u>Hard Blue mud</u> | <u>46</u> | <u>76</u> |
| <u>water sand</u> | <u>30</u> | <u>106</u> |

CODED

Information upon completion of well:

(1) Diameter 2" x 1/4" inches.

(2) Total Depth 106 feet.

(3) Water Level 50 feet below top of ground.

(4) Cased to _____, Size _____


(5) Screen: Size 1 1/4", Length 10 ft

(6) Were any formations sealed against pollution?
 _____ yes, _____ no.

If YES depth of formation _____

Why _____

Drillers Remarks: _____

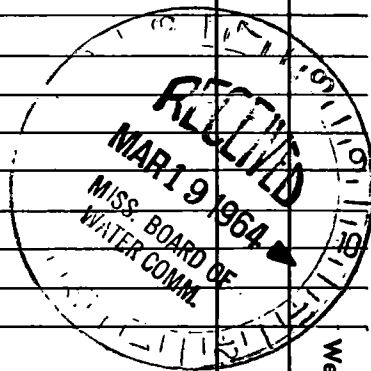

Well No.

(Use Back Side)

1900

1901

1902

1915