

Date: 6-29-1964

Driller: J. Beed
(Name)

(1) Owner of Land: Clow Deal
(Name)
Rt-1 Pass Christian
(Address)

(2) Location: SW 1/4, NW 1/4, Sec. 35 T6 R1W
10 miles W of Tub
(distance) (direction) (Nearest Town)

(3) Topography: (Hilly) (Flat) (Level)

(4) Purpose of Well: Home
(Domestic Irrigation
Municipal, Industrial, Other)

| Description & Color of Materials Sand, Clay, Red Clay, Shell, etc. | Thick- ness Feet | Depth Feet |
|---|------------------------|---------------|
| <u>Red clay + mud</u> | <u>80</u> | <u>80</u> |
| <u>Half Blue mud</u> | <u>131</u> | <u>211</u> |
| <u>Fine sand</u> | <u>30</u> | <u>241</u> |
| <u>Half Blue mud</u> | <u>180</u> | <u>521</u> |
| <u>Water strata</u> | <u>22</u> | <u>543</u> |

Information upon completion of well:

(1) Diameter 2" x 1 1/4" inches.

(2) Total Depth 543 feet.

(3) Water Level 40 feet below top of ground.

(4) Cased to _____, Size _____

(5) Screen: Size 1 1/4", Length 15 ft


(6) Were any formations sealed against pollution?
_____ yes, _____ no.

If YES depth of formation _____

Why _____

Drillers Remarks: _____

CODED

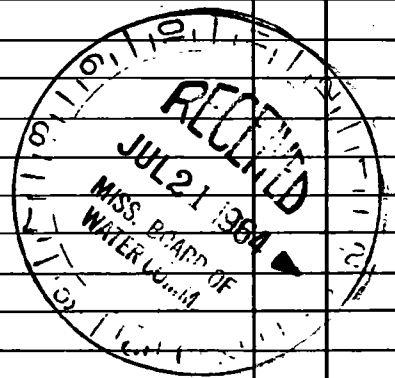

(Use Back Side)

Well No.

