

C41
2-24-64

WATER WELL DRILLERS LOG

CODED

Date: 2-24, 1964, Driller: Walter Penton County Hancock
(Name)

(1) Owner of Land: Bill Weaver
(Name)
Picayune MISS.
(Address)

(2) Location: 1/4, 1/4, Sec. 22 T6 R16,
6 miles East, of Picayune
(distance) (direction) (Nearest Town)

(3) Topography: Flat
(Hilly) (Flat) (Level)

(4) Purpose of Well: Domestic
(Domestic Irrigation
Municipal, Industrial, Other)

Description & Color of Materials Sand, Clay, Red Clay, Shell, etc.	Thick- ness Feet	Depth Feet
<u>0 to 12' clay</u>	<u>12</u>	<u>12</u>
<u>12' to 74' sand</u>	<u>62</u>	<u>74</u>
<u>74' to 236' Blue clay</u>	<u>162</u>	<u>236</u>
<u>236' to 252' sand</u>	<u>16</u>	<u>252</u>

Information upon completion of well:

(1) Diameter 2 inches.

(2) Total Depth 252 feet.

(3) Water Level 39 feet below top of ground.

(4) Cased to _____, Size _____

(5) Screen: Size .08, Length 5'


(6) Were any formations sealed against pollution?
_____ yes, _____ no.

CODED

If YES depth of formation _____

Why _____

Drillers Remarks: _____

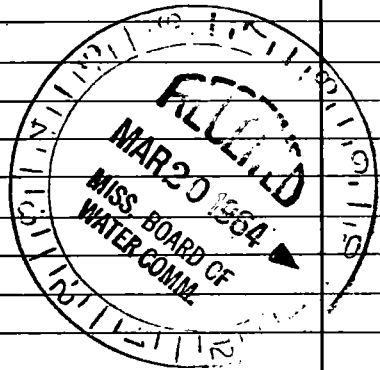

(Use Back Side)

Well No.

