

HANCOCK

C43  
7-10-64

WATER WELL DRILLERS LOG

**CODED**

Date: 7-10, 1964, Driller: Walter Pantan County Hancock  
(Name)

(1) Owner of Land: Emory Carroll  
(Name)  
Picayune Miss  
(Address)

(2) Location: 1/4, 1/4, Sec. 226R16,  
6 miles East of Picayune,  
(distance) (direction) (Nearest Town)

(3) Topography: Flat  
(Hilly) (Flat) (Level)

(4) Purpose of Well: Domestic  
(Domestic Irrigation  
Municipal, Industrial, Other)

Description & Color of Materials Sand, Clay, Red Clay, Shell, etc.	Thick- ness Feet	Depth Feet
<u>Sandy clay</u>	<u>38</u>	<u>38</u>
<u>Blue clay</u>	<u>21</u>	<u>59</u>
<u>Sand + Gravel</u>	<u>19</u>	<u>78</u>
<u>Blue clay</u>	<u>140</u>	<u>218</u>
<u>Sandy clay</u>	<u>64</u>	<u>282</u>
<u>Blue clay</u>	<u>83</u>	<u>365</u>
<u>Sand</u>	<u>15</u>	<u>380</u>
<u>Blue clay</u>	<u>222</u>	<u>602</u>
<u>Sand</u>	<u>98</u>	<u>700</u>

Information upon completion of well:

(1) Diameter 2 inches.

(2) Total Depth 700 feet.

(3) Water Level Flow feet below top of ground.

(4) Cased to \_\_\_\_\_, Size \_\_\_\_\_.

(5) Screen: Size 0/2, Length 20.


(6) Were any formations sealed against pollution?  
\_\_\_\_\_ yes, \_\_\_\_\_ no.

**CODED**

If YES depth of formation \_\_\_\_\_

Why \_\_\_\_\_

Drillers Remarks: 3 lbs Pressure

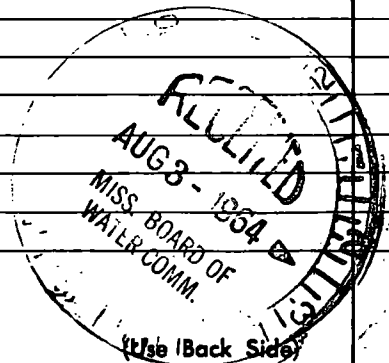

Well No.

Handwritten text at the top of the page, possibly a header or title, including the name "James M. Smith".

Vertical handwritten text on the left side of the page, possibly a list or a column of data.

Handwritten text in the upper right quadrant, including the name "James M. Smith".

Handwritten text in the middle right section of the page.

Main body of handwritten text, appearing as a large, dense block of cursive script covering the lower two-thirds of the page.