

C 44
9-15-64

WATER WELL DRILLERS LOG

CODED

Date: 9-15, 1964, Driller: Walter Penion County Hancock
(Name)

- (1) Owner of Land: Delph Keller
(Name)
Route 1 Picayune Miss
(Address)
- (2) Location: 22 $\frac{1}{4}$, 23 $\frac{1}{4}$, Sec. 23 T. 6R16,
6 1/2 miles East of Picayune,
(distance) (direction) (Nearest Town)
- (3) Topography: Flat
(Hilly) (Flat) (Level)
- (4) Purpose of Well: Domestic
(Domestic Irrigation
Municipal, Industrial, Other)

Description & Color of Materials Sand, Clay, Red Clay, Shell, etc.	Thick- ness Feet	Depth Feet
Red Clay	18	0-18
Sand	20	38
Blue Clay	208	246
Grey Sand	22	268
Blue Clay	54	322
Grey Sand	21	343
Blue Clay	122	465
Grey Sand	37	497
Blue Clay	73	570
Grey Sand	99	669
Blue Clay	87	756
Grey Sand	83	839
Blue Clay	101	940
Grey Sand	15	955
Blue Clay	33	988
Grey Sand	62	1040
Blue Clay	55	1095
Soft Blue Mud	60	1155
Hard Blue Clay	246	1401
Sand + Gravel	63	1463

Information upon completion of well:


- (1) Diameter 2 inches.
- (2) Total Depth 1463 feet.
- (3) Water Level Flow feet below top of ground.
- (4) Cased to _____, Size _____.
- (5) Screen: Size 010-012, Length 20'.
- (6) Were any formations sealed against pollution?
_____ yes, _____ no.

If YES depth of formation _____

Why _____

Drillers Remarks: 18 lbs Pressure

at Surface - did not
drill through strata

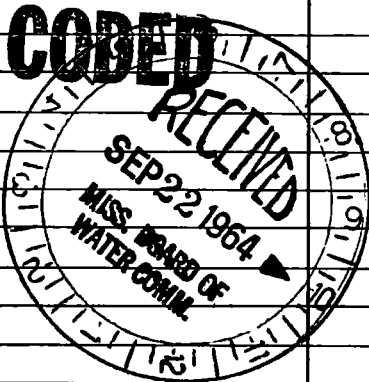

(Use Back Side)

Well No.

