

C 45

10-7-64

WATER WELL DRILLERS LOG

CODED

Date: 10-7, 1964, Driller: Walter Pantone County Hancock
 (Name)

(1) Owner of Land: Ida Mae Graham
 (Name)
Picayune Miss
 (Address)

(2) Location: 1/4, 1/4, Sec. 23 T6 R16,
7 miles East of Picayune,
 (distance) (direction) (Nearest Town)

(3) Topography: Hilly
 (Hilly) (Flat) (Level)

(4) Purpose of Well: Domestic
 (Domestic Irrigation
 Municipal, Industrial, Other)

Description & Color of Materials Sand, Clay, Red Clay, Shell, etc.	Thick- ness Feet	Depth Feet
<u>Red Sandy Clay</u>	<u>16</u>	<u>0-16</u>
<u>Sand</u>	<u>62</u>	<u>78</u>
<u>Blue Clay</u>	<u>479</u>	<u>557</u>
<u>Sand</u>	<u>30</u>	<u>587</u>

Information upon completion of well:

CODED

(1) Diameter 2 inches.

(2) Total Depth 587 feet.

(3) Water Level Flow feet below top of ground.

(4) Cased to _____, Size _____


(5) Screen: Size 010, Length 5'

(6) Were any formations sealed against pollution?
 _____ yes, _____ no.

If YES depth of formation _____

Why _____

Drillers Remarks: _____

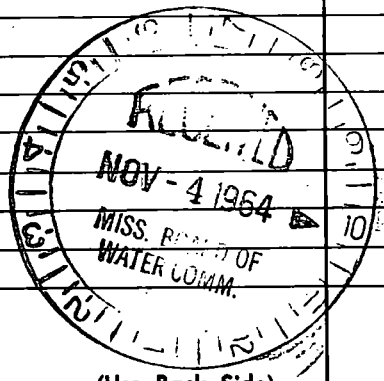

(Use Back Side)

Well No.

