

HANCOCK MISSISSIPPI BOARD OF WATER COMMISSIONERS

C48

3-25-66

WATER WELL DRILLERS LOG

CODED

Date: 3-25, 1966, Driller: Walter Penitoni County Hancock

(Name)

(1) Owner of Land: Alton Lumpkin
(Name)

Rt. 3 Piquemie Miss
(Address)

(2) Location: 1/4, 1/4, Sec. 4 T 6 R 5 E,
8 miles East of Piquemie
(distance) (direction) (Nearest town)

(3) Topography: Hilly
(Hilly) (Flat) (Level)

(4) Purpose of Well: Domestic
(Domestic Irrigation
Municipal, Industrial, Other)

Description & Color of Materials
Sand, Clay, Red Clay, Shell, etc.

Thick-
ness
Feet

Depth
Feet

Clay
Sand

32 0 to 32
35 67

Blue Clay
Grey Sand
Blue Clay
Grey Sand

193 260
5 265
142 407
36 443

Information upon completion of well:


- (1) Diameter 2 inches.
- (2) Total Depth 443 feet.
- (3) Water Level -52 feet below top of ground.
- (4) Cased to _____, Size _____.
- (5) Screen: Size 10/12, Length 5'.
- (6) Were any formations sealed against pollution?
_____ yes, _____ no.

If YES depth of formation _____

Why _____

Drillers Remarks: _____

CODED

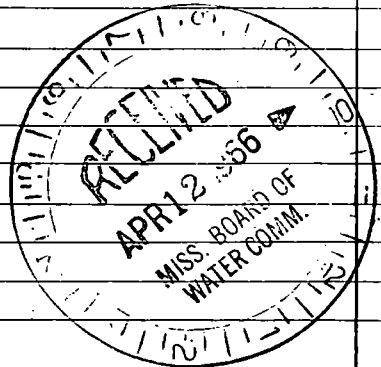

(Use Back Side)

Well No.

