

C 50

6-10-66

WATER WELL DRILLERS LOG

CODED

Date: 6-10, 1966, Driller: Walter Peniton County HANCOCK

(Name)

(1) Owner of Land: Paul Fleming
 (Name)
Rt. 3, Picaune, Miss
 (Address)

Description & Color of Materials
 Sand, Clay, Red Clay, Shell, etc.

Thick-
ness
Feet

Depth
Feet

Red clay

24 0-24

" Mud

12 36

Sand

40 76

Blue clay

178 254

Grey Sand

274 278

(2) Location: 1/4, 1/4, Sec. 4 T6R15,
10 1/2 miles East, of Picaune,
 (distance) (direction) (Nearest Town)

(3) Topography: Hilly
 (Hilly) (Flat) (Level)

(4) Purpose of Well: Domestic
 (Domestic Irrigation
 Municipal, Industrial, Other)

Information upon completion of well:

(1) Diameter 2 inches.

(2) Total Depth 278 feet.

(3) Water Level 63 feet below top of ground.

(4) Cased to _____, Size _____.

(5) Screen: Size 1010, Length 5'

(6) Were any formations sealed against pollution?


_____ yes, _____ no.

If YES depth of formation _____.

Why _____.

Drillers Remarks: _____

CODED

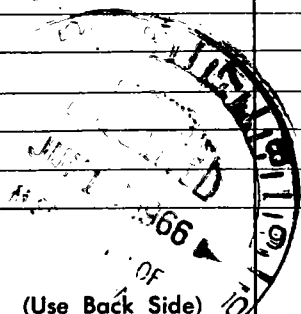

(Use Back Side)

Well No. _____

