

**HANCOCK**  
**C 55**  
**12-2-72**

MISSISSIPPI  
 BOARD OF WATER COMMISSIONERS  
 416 North State Street  
 Jackson, Mississippi 39201

WATER WELL DRILLERS LOG

**CODED**

12-2  
 date well completed

1972 Peniston Well Serv  
 firm name

HANCOCK  
 county well located

LANDOWNER: Alton Lumpkin

description of formations encountered

from to

Rt. 1

Surface Clay

0 25

Picayune Miss

Sand

25 55

(mailing address)

Blue Clay

55 195

WELL LOCATION:

Mud

195 225

sec 29 T 6 S R 15 W

Blue Clay

225 440

Fine Sand

440 452

13 miles East of Picayune  
 (distance) (direction) (nearest town)

Blue Clay

452 920

Sand

920 995

WELL PURPOSE: Home  
 (home, irrigation, municipal, industrial)

WELL COMPLETION DATA:

(1) diameter (inches) 2

(2) total depth (feet) 995

(3) static water level (feet) Flow ~~level~~ above top of ground.

(4) casing Galv, 975  
 (material) (depth)

2 if telescope see back.  
 (size)

(5) screen 20', 975  
 (length) (depth to top)

2, S. Steel  
 (size) (material)

(6) pump C, 45  
 (HP) (yield gpm)

(type power)

(7) electric log NO  
 (yes or no)

(organization running log)

(8) how well bottom plugged B.W. Valve


**CODED**

DRILLERS REMARKS: 16 lbs.

DEC 19 1972

If well telescopes please sketch and show depths.

GROUND LEVEL

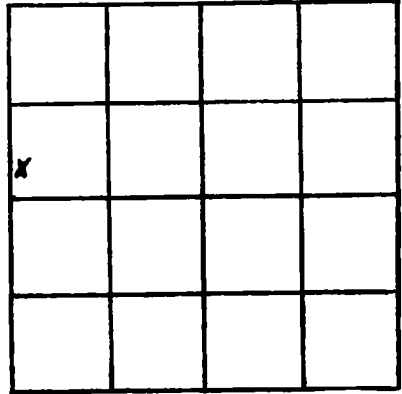

SECTION 29

Please indicate well location X.

ADDITIONAL INFORMATION

If more than one screen, show locations of each on sketch.