

HANCOCK
C65
8-7-74

MISSISSIPPI
 BOARD OF WATER COMMISSIONERS
 416 North State Street
 Jackson, Mississippi 39201

CODED

WATER WELL DRILLERS LOG

Aug. 7 1974
 date well completed

Wardwell Drilling
 firm name

Hancock
 county well located

LANDOWNER: L. Haywood
General Delivery
Revelington, Miss
 (mailing address)

description of formations encountered	from	to
<u>Top Soil - clay</u>	<u>0</u>	<u>15</u>
<u>sd</u>	<u>15</u>	<u>28</u>
<u>Clay - silt</u>	<u>28</u>	<u>67</u>
<u>Clay - Shell</u>	<u>67</u>	<u>86</u>
<u>Clay</u>	<u>86</u>	<u>90</u>
<u>sd</u>	<u>90</u>	<u>105</u>

WELL LOCATION:

sec. 19 T. 6 N. R. 15 E
17 miles NW of B.S.L.
 (distance) (direction) (nearest town)

WELL PURPOSE: Home
 (home, irrigation, municipal, industrial)

WELL COMPLETION DATA:

- (1) diameter (inches) 2"
- (2) total depth (feet) 105
- (3) static water level (feet) 7 ^{below} _{above} top of ground.
- (4) casing 2" PVC, 100'
 (material) (depth)
- _____ If telescope see back.
 (size)
- (5) screen 5'
 (length) (depth to top)
- 2", SCH. PVC
 (size) (material)
- (6) pump 1/2 7
 (HP) (yield gpm)
- Elec
 (type power)
- (7) electric log no
 (yes or no)
- N/A
 (organization running log)
- (8) how well bottom plugged BWU

CODED


RECEIVED
 SEP - 6 1974

DRILLERS REMARKS: N/A

MISS. BU. OF WATER

If well telescopes please sketch and show depths.

GROUND LEVEL

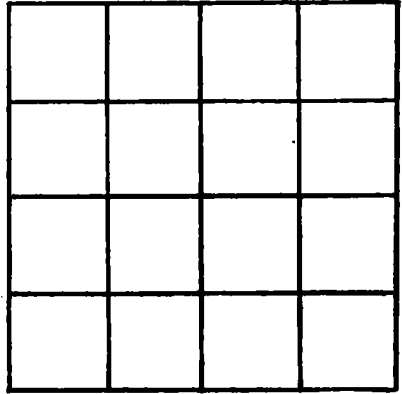

SECTION 19

Please indicate well location X.

ADDITIONAL INFORMATION

If more than one screen, show locations of each on sketch.