

C 70
 Hancock
 5/26/75

MISSISSIPPI
 BOARD OF WATER COMMISSIONERS
 416 North State Street
 Jackson, Mississippi 39201

CODED

WATER WELL DRILLERS LOG

5-26 1975 Penton Well Serv Hancock
 date well completed firm name county well located

LANDOWNER: Richard Kell
 Rt. 1 Box 232
 Picayune MS
 (mailing address)

| description of formations encountered | from | to |
|---------------------------------------|------|-----|
| Surface Clay | 0 | 15 |
| Sand | 15 | 30 |
| Sand + Clay | 30 | 95 |
| Blue Clay | 95 | 275 |
| Sand | 275 | 299 |

WELL LOCATION:
 sec 22 T 6 M R 16 D
 S W
 5 miles East of Picayune
 (distance) (direction) (nearest town)

WELL PURPOSE: Home
 (home, irrigation, municipal, industrial)

WELL COMPLETION DATA:

(1) diameter (inches) 2

(2) total depth (feet) 299

(3) static water level (feet) 38 below
 top of ground.

(4) casing Galv., 289,
 (material) (depth)
 2 if telescope see back.
 (size)

(5) screen 10', 289
 (length) (depth to top)
 2, S. Steel
 (size) (material)

(6) pump 1/2 8
 (HP) (yield gpm)
 Elec
 (type power)

(7) electric log N/C
 (yes or no)

(organization running log)

(8) how well bottom plugged Bev. Valve


DRILLERS REMARKS:

JUN 8 1975

MISS. BD. OF WATER COMMISSIONERS

If well telescopes please sketch and show depths.

GROUND LEVEL

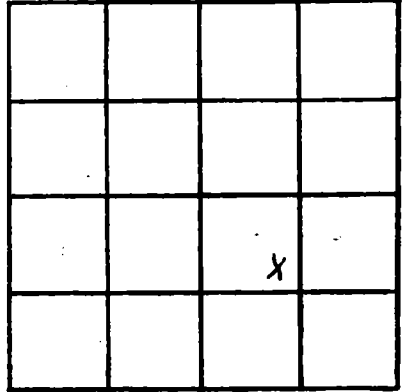

SECTION 22

Please indicate well location X.

ADDITIONAL INFORMATION

If more than one screen, show locations of each on sketch.