

HANCOCK  
C73  
3-68

MISSISSIPPI  
BOARD OF WATER COMMISSIONERS  
416 North State Street  
135 Jackson, Mississippi 39201

WATER WELL DRILLERS LOG CODED

3-21-68 1968 Pantoni Well Serv Hancock  
date well completed firm name county well located

LANDOWNER: James C. Lee

Rt. 1, Box 237 B

Picayune Miss  
(mailing address)

WELL LOCATION:

sec. 23 T. 6 S. R. 16 W.  
6 miles East of Picayune  
(distance) (direction) (nearest town)

WELL PURPOSE: Home  
(home, irrigation, municipal, industrial)

WELL COMPLETION DATA:

- (1) diameter (inches) 2"  
(2) total depth (feet) 1038  
(3) static water level (feet) 20' <sup>below</sup> above top of ground.  
(4) casing Black S. 1008  
(material) (depth)

         if telescope see back.  
(size)

(5) screen 30' 1008  
(length) (depth to top)

012 2" S. steel  
(size) (material)

(6) pump            
(HP) (yield gpm)

          
(type power)

(7) electric log NO  
(yes or no)

          
(organization running log)


(8) how well bottom plugged BW Valve

description of formations encountered

from to

Red Clay	0	22
Sand	22	55
Blue Clay	55	80
Black "	80	92
Blue "	92	180
Grey Sand	180	200
Blue Clay	200	248
Grey Sand	248	275
Blue Clay	275	570
Grey Sand	570	685
Blue Clay	685	840
Grey Sand	840	855
Blue Clay	855	987
Grey Sand	987	1038

CODED

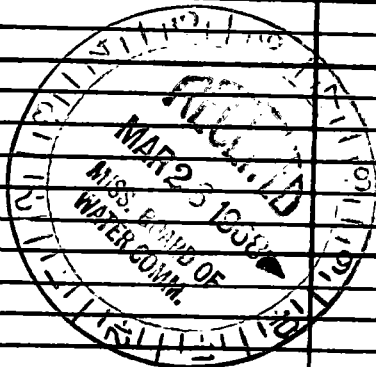


DRILLERS REMARKS:

If well telescopes please sketch and show depths.

GROUND LEVEL

3"

63'

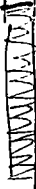

X			

SECTION 2B

Please indicate well location X.

ADDITIONAL INFORMATION

If more than one screen, show locations of each on sketch.