

Nancoch
C 74
11-67

MISSISSIPPI
 BOARD OF WATER COMMISSIONERS
 416 North State Street
 Jackson, Mississippi 39201
CODED

WATER WELL DRILLERS LOG

11-24 1967 Sutton Well Works Nancoch
 date well completed firm name county well located

LANDOWNER: John Numbink
Rt. 3 Box 310

Picayune Miss.
 (mailing address)


WELL LOCATION:
 sec. 34 T. 6 S. R. 15 W.
7 miles NW of Kelm
 (distance) (direction) (nearest town)

WELL PURPOSE: Drinking - domestic
 (home, irrigation, municipal, industrial)

WELL COMPLETION DATA:

- (1) diameter (inches) 4
- (2) total depth (feet) 1119
- (3) static water level (feet) +40 above top of ground.
- (4) casing 4" galv 1099'
 (material) (depth)
- 4" if telescope see back.
 (size)
- (5) screen 20' 1099'
 (length) (depth to top)
- 4" stainless steel
 (size) (material)
- (6) pump none
 (HP) (yield gpm)
- (type power)
- (7) electric log no
 (yes or no)
- (organization running log)
- (8) how well bottom plugged B.P. Value

description of formations encountered	from	to
Surface Clay	0	10
Clay - sand streaks	10	105
Clay	105	195
Sand	195	250
Clay - sand str.	250	340
Sand	340	505
Clay	505	550
Sand	550	570
Clay	570	716
Clay sand	716	779
Clay sand str.	779	1050
Gravel	1050	1119

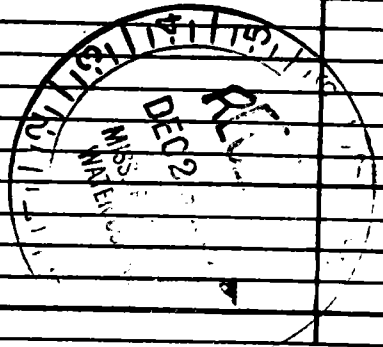

DRILLERS REMARKS:

If well telescopes please sketch and show depths.

GROUND LEVEL

	X		

SECTION 34

Please indicate well location X.

ADDITIONAL INFORMATION

If more than one screen, show locations of each on sketch.