

Hancock
 C75
 3-67

MISSISSIPPI
 BOARD OF WATER COMMISSIONERS
 416 North State Street
 135 Jackson, Mississippi 39201

WATER WELL DRILLERS LOG

Mar. 28, 1967 Well Drilling Service Hancock
 date well completed firm name county well located

LANDOWNER: Chester Lee
Picayune, Miss.
Route
 (mailing address)

WELL LOCATION:
 sec 25 T 6 N R 16 E
12 miles EAST of Picayune
 (distance) (direction) (nearest town)

WELL PURPOSE: Home
 (home, irrigation, municipal, industrial)

WELL COMPLETION DATA:

- (1) diameter (inches) 2"
- (2) total depth (feet) 1575'
- (3) static water level (feet) +18' feet above top of ground.
- (4) casing metal, 1555'
 (material) (depth)
2 1/2"
 (size) If telescope see back.
- (5) screen 20'
 (length) (depth to top)
24" metal
 (size) (material)
- (6) pump _____
 (HP) (yield gpm)

 (type power)
- (7) electric log no.
 (yes or no)
- _____ (organization running log)
- (8) how well bottom plugged Johnson Lock
pressure valve

description of formations encountered	from	to
Surface clay	0	10
" sand	10	30
Blue clay	30	160
good sand	160	200
blue clay	200	400
good sand	400	550
blue clay	550	1000
good sand	1000	1105
blue clay	1105	1350
good sand	1350	1420
blue clay	1420	1490
good sand	1490	1575


CODED



DRILLERS REMARKS: full pipe about nine lbs. pressure.

If well telescopes please sketch and show depths.

GROUND LEVEL

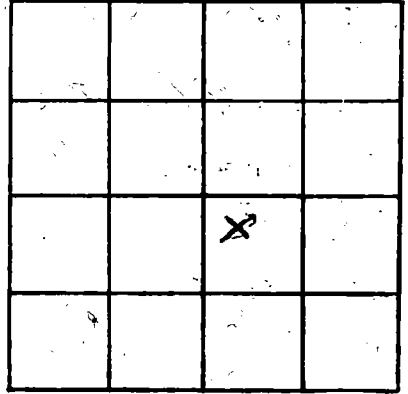

SECTION 25

Please indicate well location X.

ADDITIONAL INFORMATION

If more than one screen, show locations of each on sketch.