

Hancock  
C 76  
8-66

MISSISSIPPI BOARD OF WATER COMMISSIONERS

135 WATER WELL DRILLERS LOG CODED

Date: 8-11, 1966, Driller: Walter Penton County Hancock  
(Name)

(1) Owner of Land: Frank Maggonie  
(Name)  
No. O. L. 2.  
(Address)

(2) Location: SW 1/4, SW 1/4, Sec. 23 T6R16  
5 1/2 miles East of Picayune  
(distance) (direction) (Nearest Town)  
MISS.

(3) Topography: Level  
(Hilly) (Flat) (Level)

(4) Purpose of Well: Domestic  
(Domestic Irrigation  
Municipal, Industrial, Other)

Description & Color of Materials Sand, Clay, Red Clay, Shell, etc.	Thick- ness Feet	Depth Feet
Clay	30	0-30
Sand	42	72
Blue clay	44	116
Sand	8	124
Blue clay	94	218
Grey Sand	79	297
Blue clay	73	370
Grey Sand	40	410
Blue clay	198	608
Grey Sand	16	624
Blue clay	363	987
Grey Sand	113	1100

Information upon completion of well:

(1) Diameter 2 inches. 4 1/2" drilled

(2) Total Depth 1100 feet.

(3) Water Level Flow +21' feet below top of ground.


(4) Cased to 1080, Size 2"

(5) Screen: Size 010, Length 20'

(6) Were any formations sealed against pollution?  
\_\_\_\_\_ yes, \_\_\_\_\_ no.

If YES depth of formation \_\_\_\_\_  
Why \_\_\_\_\_

Drillers Remarks: 9 lbs Pressure  
at Ground level  
Flowing well

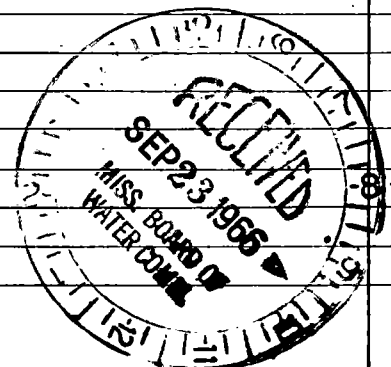

(Use Back Side)

Well No.

