

MISSISSIPPI DEPARTMENT OF NATURAL RESOURCES

Bureau of Land and Water Resources

Southport Mall

P.O. Box 10631

Jackson, Mississippi 39209

WATER WELL DRILLERS LOG

CODED

Hancock
C 87
7-10-81

7-10-81
date well completed

Griner Drilling Service, Inc
firm name

Hancock
county well located

LANDOWNER:

Hunt Energy Corp.

P.O. Box 4096
Throuma, La

(mailing address)

description of formations encountered

from

to

Clay

0 21

sand

21 50

streaked

50 105

chalk

105 294

streaked

294 315

chalk

315 378

streaked

378 441

chalk

441 504

sand

504 525

chalk

525 567

sand, pea gravel

567 630

chalk

630 650

WELL LOCATION: 1900' N + 1500' W of
Yoda 29 6 N R 15 E S 1/4
Brown 11 miles South of
Primmer, La

WELL PURPOSE: oil field
(home, irrigation, municipal, industrial, etc.)

WELL COMPLETION DATA:

- (1) diameter (inches) 4"
- (2) total depth (feet) 650'
- (3) static water level (feet) 20' below top of ground.
- (4) casing steel, 630'
(material) (depth)
- 4"
(size) if telescope see back.
- (5) screen 42', 588'
(length) (depth to top)
- 4", perforated
(size) (material)
- (6) pump 80
(HP) (yield gpm)
- ac
(type power)
- (7) electric log —
(yes or no)


(organization running log)

(8) how well bottom plugged orange
peel

DRILLERS REMARKS:

CODED

1900' N + 1500' W
of SE

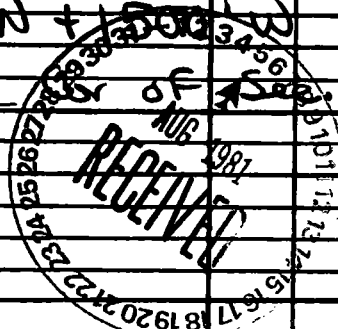

If well telescopes please sketch and show depths.

03000

GROUND LEVEL

SECTION _____

Please indicate well location X.

ADDITIONAL INFORMATION

If more than one screen, show locations of each on sketch.