

MISSISSIPPI DEPARTMENT OF NATURAL RESOURCES

Bureau of Land and Water Resources

Southport Mall

P.O. Box 10631

Jackson, Mississippi 39209

CODED

WATER WELL DRILLERS LOG

Griner Drilling Service, Inc.

Hancock

Hancock
C 91
1-28-82

1-28-82
date well completed

firm name

county well located

LANDOWNER:	description of formations encountered	from	to
Hunt Energy Corporation P.O. Box 4096 Houma, La (mailing address)	sand, pea gravel	0	42
	chalk	42	105
WELL LOCATION: 2000' S + 1500' W No. 1 Loc. B T 6 N R 15 E NE/4 S.G. Upper Catahoula Cr. Field The (distance) miles (direction) (nearest town)	streaked	105	231
	chalk	231	252
WELL PURPOSE: oil field supply (home, irrigation, municipal, industrial)	chalk, sand	252	273
WELL COMPLETION DATA:	sand	273	336
(1) diameter (inches) 4"	chalk	336	378
(2) total depth (feet) 378'			
(3) static water level (feet) 10' below top of ground			
(4) casing Steel 336' (material) (depth) 4" (size) if telescope see back.			
(5) screen 42' 294' (length) (depth to top) 4" perforated (size) (material)			
(6) pump AC (HP) (yield gpm)			
(7) electric log (yes or no) (organization running log)			
(8) how well bottom plugged Orange Ded			
DRILLERS REMARKS:			

CODED


DEPT. OF NATURAL RESOURCES
BUREAU OF LAND & WATER RESOURCES

FEB - 4 1982

RECEIVED

If well telescopes please sketch and show depths.

GROUND LEVEL

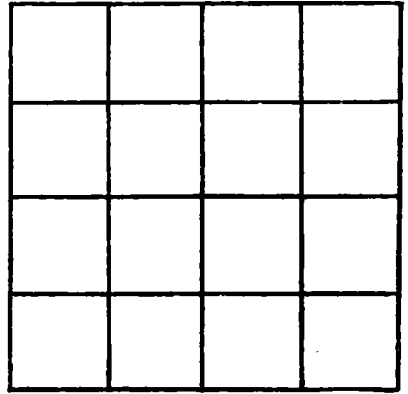

SECTION _____

Please indicate well location X.

ADDITIONAL INFORMATION

If more than one screen, show locations of each on sketch.