

MISSISSIPPI DEPARTMENT OF NATURAL RESOURCES

Bureau of Land and Water Resources

Southport Mall

P.O. Box 10631

CODED

Jackson, Mississippi 39209

WATER WELL DRILLERS LOG
COASTAL DRILLING & SERVICE CO.

Hancock
C 92
1/4/82

ROUTE 1 BOX 618

Hancock
county well located

1/4/82
date well completed

BILOXI MISS 39532
firm name

Heat Energy Corp
P.O. Box 4098
Hannawa
Cahoon (mailing address)

description of formations encountered	from	to
top soil	1	3
Red Clay	3	15
white sand down	15	100
Soft Blue Clay	100	110
Sandy Sand	110	140
Soft Blue Clay	140	180
White Sand	180	240
Soft Blue Clay	240	310
good water sand	310	360
Hard Blue Clay	360	460
good water sand	460	540
Hard Blue Clay	540	760
fine water sand	760	790
good water sand	790	840
Hard Blue Clay	840	940
fine water sand	940	960
good water sand	960	1020

WELL LOCATION:

sec 28 T 6 N R 15 E
S W
7 min from line
(distance) (direction) (nearest town)

WELL PURPOSE: Industrial
(home, irrigation, municipal, industrial)

WELL COMPLETION DATA:

- (1) diameter (inches) 4"
- (2) total depth (feet) 1020'
- (3) static water level (feet) 32' below top of ground
- (4) casing 3" steel 980' (material) (depth)
- (size) If telescope see back.
- (5) screen 40' 980' (length) (depth to top)
- 4" SS (size) (material)
- (6) pump 3 1/2 hp 50 gpm (HP) (yield gpm)
- Ele (type power)
- (7) electric log no (yes or no)
- (organization running log)

CODED

DEPT. OF NATURAL RESOURCES
BUREAU OF LAND & WATER RESOURCES

JAN 15 1982


RECEIVED

(8) how well bottom plugged

DRILLERS REMARKS:
Log good well

If well telescopes please sketch and show depths.

GROUND LEVEL

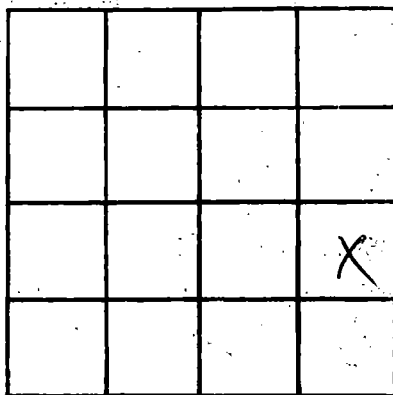

SECTION _____

Please indicate well location X.

ADDITIONAL INFORMATION

If more than one screen, show locations of each on sketch.