

MISSISSIPPI DEPARTMENT OF NATURAL RESOURCES

Bureau of Land and Water Resources

Southport Mall

P.O. Box 10631

CODED

Jackson, Mississippi 39209

WATER WELL DRILLERS LOG

POUNCEY WATER WELL DRILLING

Hancock

Hancock
C 96
4-2-85

4-2 1985 date well completed firm name Hancock county well located

LANDOWNER: Al Baker
Cuenos Rd.

description of formations encountered from to

(mailing address)

Top of CODED 4
SD. 4 31

WELL LOCATION:
sec. 35 T 6 N R 15 E
4 1/2 miles N of Kiln
(distance) (direction) (nearest town)

Clay & Shales 31 92
Clay 92 388

WELL PURPOSE: House
(home, irrigation, municipal, industrial)

SD. 388 462

WELL COMPLETION DATA:

fine to fair SD. 462 496

(1) diameter (inches) 2

(2) total depth (feet) 496

(3) static water level (feet) 47 below top of ground

(4) casing PVC 481
(material) (depth)

2 (size) if telescope see back.

(5) screen 15 481
(length) (depth to top)

2 (size) PVC (material)

(6) pump 1 (HP) 10 (yield gpm)

230V AC (type power)

(7) electric log (yes or no)

(organization running log)

(8) how well bottom plugged Sealed



DRILLERS REMARKS:

RECEIVED
MAY 28 1985

Department of Natural Resources
Bureau of Land & Water Resources

If well telescopes please sketch and show depths.

GROUND LEVEL

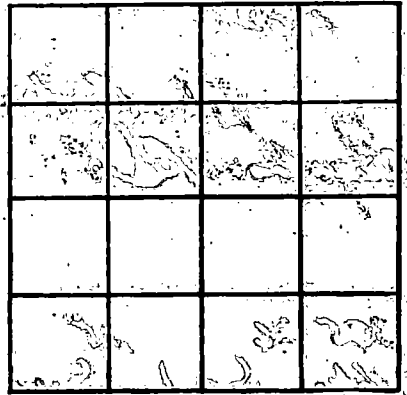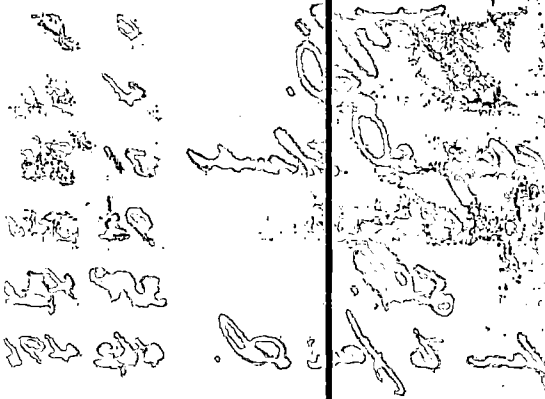

SECTION _____

Please indicate well location X.

ADDITIONAL INFORMATION

A series of horizontal lines for providing additional information. The lines are spaced evenly and extend across the width of the page.

If more than one screen, show locations of each on sketch.