

MISSISSIPPI DEPARTMENT OF NATURAL RESOURCES

Bureau of Land and Water Resources

Southport Mall

P.O. Box 10631

Jackson, Mississippi 39209

WATER WELL DRILLERS LOG

CODED

C 97
 HANCOCK
 8-6-85

8-6 1985 McMill Pumps Well Hancock
 date well completed firm name county well located

LANDOWNER: I-43 Lounge
Rt. 1 Box 290 E
Picayune Ms. 39466
 (mailing address)

WELL LOCATION:
 sec. 27 T. 6 N R. 15 E
9 miles NW of Kiln
 (distance) (direction) (nearest town)

WELL PURPOSE:
 (home, irrigation, municipal, industrial)

WELL COMPLETION DATA:

(1) diameter (inches) 2"
 (2) total depth (feet) 360'
 (3) static water level (feet) 10' below above top of ground.
 (4) casing Sch. 40 PVC 350'
 (material) (depth)
 (size) if telescope see back.
 (5) screen 10' 350'
 (length) (depth to top)
2" Sch. 80-6 slot PVC
 (size) (material)
 (6) pump N/A
 (HP) (yield gpm)
 (type power)
 (7) electric log (yes or no)
 (organization running log)
 (8) how well bottom plugged SAND
SHARK

description of formations encountered	from	to
Mud/Sand	0	20
Sand/Mud	20	40
Mud	40	160
Mud/Sand	160	180
Sand/Mud	180	200
Mud	200	220
Mud/Sand	220	240
Sand/Mud	240	260
Mud	260	300
Mud/Sand	300	320
Sand	320	360


RECEIVED
 OCT - 8 1985

DRILLERS REMARKS:

Department of Natural Resources
 Bureau of Land & Water Resources

If well telescopes please sketch and show depths.

GROUND LEVEL

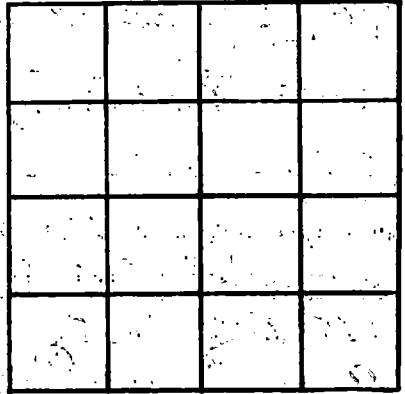

SECTION _____

Please indicate well location X.

ADDITIONAL INFORMATION

If more than one screen, show locations of each on sketch.