ounty $\exists r \ L r \ \ L r \ L $	Part 1 Driller's Log	For Office Use Only: Well #:
ermit #: riller: $\underline{M},\underline{5},\underline{7},\underline{7},\underline{7},\underline{7},\underline{7},\underline{7},\underline{7},7$	Driller's Log	1, 1, 1, 1, 1, 1, 1, 1, 1, 1, 1, 1, 1, 1
riller: M.SLLVK2		
	Mississippi Department of Environmental Quality Office of Land and Water Resources	Aquifer:
	P.O. Box 2309	E-Log #:
ate drilling completed:	Jackson, MS 39225-2309 (601)961-5210	LRECEIV
	(601)360-0535 (fax)	NOV 08 20
State Law requires that this report	be prepared by the license holder responsible for ithin 30 days of completion of drilling of the well	the work and filed with the
Well Owner Informati		shale leastion 1.1 -
(Landowner if borehole is not for	a water well) 7D 28 57	ongitude: 87 28 29.55
Dwner Name: MR. RUSSEL		
Mailing Address: RL L		ne): Conventional Survey,
	USGS quad, Hand-held	GPS+, Survey-grade GPS
KILD MS	<u>SW 4 NW 4, Sec</u>	35 T.65 RISW
City State	Zip Code 15 Miles	
Felephone No. ()		(Nearest Town)
	ជិក Electric Gamma Ray Density Sonic Neut	
	Wex Geotechnical/Geological Investigation	Ground Source Heat Pump
Purpose of borehole (circle one): Water		
	ic Survey Other (describe)ated to water well construction, skip the remainded	er of this block
		Fish Culture
Purpose of Well (circle all applicable):		isin culture
f a flowing well, method of flow regula	ation: Valve Other (<i>describe</i>)	
Static Water Level: <u>6</u> feet	Elabove of below hand surface Date measure (circle one)	
<u> </u>	iteel tape Electric tape Air line Other (describe	
Well depth: <u>343′</u> Well grouted to a	depth of: 12 feet Type of grout (circle one): Neat Cement Bentonite (Mix)
Casing length: <u>323</u> feet Ca	asing diameter:inches Type of	
Screen length: <u></u> feet S	Screen diameter:inches Type o	if screen: $\underline{\nu} \sqrt{\langle}$
Screen slot size: \mathcal{DDL} inches		to <u>}</u> feet
Type of completion (circle all applicable	e): Gravel packed Underreamed Open hole	e Natural Development
Other (describe):		
Top of lap pipe or reduction in casing:	feet	

J

RECEIVED State 3.6 2006 RWIGYS

م مقاد الإيراني من ما ترجي مرافقة من ما ترجي

> د م د به د دمومین ^۲ د ۲۰۰۰

I
County: HANEVER
Permit #:


. .

For Office Use Only: Ciiq Well #: ____ EC#IVED

R

The sketch below only required for water wells

If well telescopes, show depths on sketch.

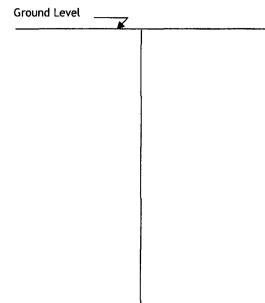

Description of formations encountered	must be provide	ed for all wells	
and boreholes, unless specifically exem	pted by regulati	ions NOV D	8 201
Description of Formations Encountered	From (depth)	To (depth)	
Sad 4	Ground level		N
Jun 4	120		
CLAY	130	370,	
SARA	J77	31-1-1-1	
		2.17	
		<u> </u>	
	1		
	+		
	+	· · · · · · · · · · · · · · · · · · ·	
	+		

If more than one screen, show location of each on sketch

.

Sketch the property layout and include the following: 1) the well location 2) any permanent structures on the property that may aid in locating the well 3) any reads, power lines, or other items that may aid in locating the property

 any permanent structures on the property that may aid in locating the well any roads, power lines, or other items that may aid in locating the property and the well north arrow 	zvas Julin
WEITER 2554	PWN RL
DAIVE MORENTE	
Landowner Name:	١
I HEREBY CERTIFY that the well/borehole was drilled, constructed, and completed in accordance with all applica requirements of the Mississippi Department of Environmental Quality and the Mississippi Department of Health re if applicable, and state laws.	able egulations,
M:147 512-210 477 10/10/18	
Print Name of Responsible Licensee and License No. Date Signature of Licensee	WR-1B (4/13)
	ננו זרי סו אוויי)

RECENTED RYOLWR

1 an

1

na series de la companya de la companya

March & Bas

in the state