

C 2003  
2-5-63

WATER WELL DRILLERS LOG

C

Date: 2-5, 19 63, Driller: Sutter Well Works County Hancock  
(Name)

(1) Owner of Land: John Campbell  
(Name)  
Lectown, Miss  
(Address)

(2) Location: SE 1/4, NE 1/4, Sec. 5 T6S R15W  
12 miles E, of Picayune  
(distance) (direction) (Nearest town)

(3) Topography: Hilly  
(Hilly) (Flat) (Level)

(4) Purpose of Well: domestic  
(Domestic Irrigation  
Municipal, Industrial, Other)

Description & Color of Materials Sand, Clay, Red Clay, Shell, etc.	Thick- ness Feet	Depth Feet
red clay	115	115
clay	92	207
sand	33	240

Information upon completion of well:

(1) Diameter 2 inches.


(2) Total Depth 235 feet.

(3) Water Level 59 feet below top of ground.

(4) Cased to all, Size 2"

(5) Screen: Size 2", Length 10'

(6) Were any formations sealed against pollution?  
yes, no.

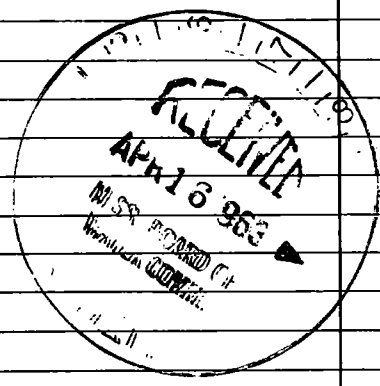

If YES depth of formation \_\_\_\_\_

Why \_\_\_\_\_

Drillers Remarks: \_\_\_\_\_

Well No.

(Use Back Side)

John H. ... ..

1912  
MAY 21  
1912

...

John H. ... ..

...

...

