

C 2007

1-11-64

WATER WELL DRILLERS LOG

Date: 1-11, 1964, Driller: Walter Pentecost County Hancock
 (Name)

(1) Owner of Land: Hollis Lee
 (Name)
Picayune Miss
 (Address) ^{20 6 15}_{39 6 16}
 (2) Location: 9 miles East of Picayune,
 (distance) (direction) (Nearest Town)
 (3) Topography: Hilly
 (Hilly) (Flat) (Level)
 (4) Purpose of Well: Domestic
 (Domestic Irrigation
 Municipal, Industrial, Other)

| Description & Color of Materials Sand, Clay, Red Clay, Shell, etc. | Thick- ness Feet | Depth Feet |
|---|------------------------|---------------|
| 0 to 16' clay | 16 | 16 |
| 16 to 38' sand | 22 | 38 |
| 38 to 97' Blue clay | 49 | 97 |
| 97 to 146 sand | 49 | 146 |
| 146 to 165 Blue clay | 19 | 165 |
| 165 to 178 sand | 13 | 178 |
| 178 to 256 Blue clay | 78 | 256 |
| 256 to 316 sand | 60 | 316 |
| 316 to 438 Blue clay | 122 | 438 |
| 438 to 480 sand | 42 | 480 |
| 480 to 915 Blue clay | 435 | 915 |
| 915 to 980 sand | 65 | 980 |
| 980 to 998 Blue clay | 18 | 998 |
| 998 to 1098 sand | 100 | 1098 |

Information upon completion of well:


(1) Diameter 2 inches.
 (2) Total Depth 1098 feet.
 (3) Water Level Flow feet below top of ground.
 (4) Cased to _____, Size _____
 (5) Screen: Size _____, Length _____
 (6) Were any formations sealed against pollution?
 _____ yes, _____ no.

If YES depth of formation _____

Why _____

Drillers Remarks: _____

17.5 lbs. Water pressure

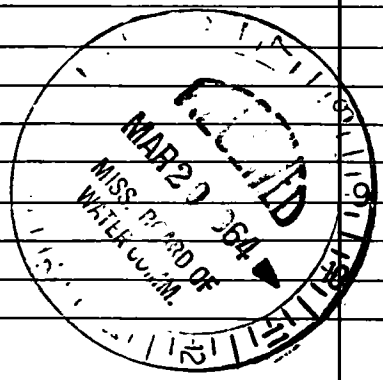

(Use Back Side)

Well No.

