

C 2016

3-15-65

WATER WELL DRILLERS LOG

A

Date: 3-15, 1965, Driller: Walter Ponton, County Hancock

(Name)

(1) Owner of Land: Victor Powell (Name) Rt. 3 Picaune Miss (Address)

Table with 3 columns: Description & Color of Materials, Thickness Feet, Depth Feet. Rows include Red Clay (22 ft, 22 ft), Mixed Sand & Clay (43 ft, 65 ft), Brown Mud (38 ft, 103 ft), Blue Clay (157 ft, 260 ft), Silt (28 ft, 278 ft), Clay (100 ft, 368 ft), Grey Sand (32 ft, 400 ft).

(2) Location: 1/4, 1/4, Sec. T R, 12 miles East of Picaune (distance, direction, Nearest Town)


(3) Topography: Hilly (Hilly, Flat, Level)

(4) Purpose of Well: Domestic (Domestic Irrigation, Municipal, Industrial, Other)

Information upon completion of well:

(1) Diameter 2 inches. (2) Total Depth 400 feet. (3) Water Level 35 feet below top of ground. (4) Cased to Size. (5) Screen: Size 010, Length 5'. (6) Were any formations sealed against pollution? yes, no.

If YES depth of formation Why Drillers Remarks:

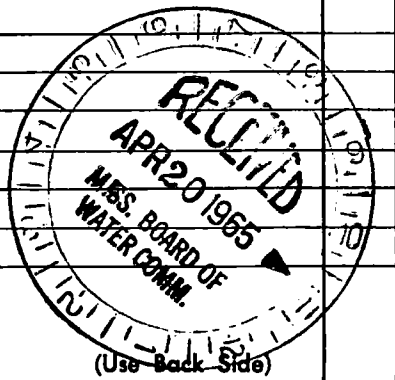

Well No.

