

6-66

WATER WELL DRILLERS LOG

Hancock

Date: 6-18, 1966, Driller: NEIL HUMPHIN County PEARL RIVER

(Name)

(1) Owner of Land: W. J. Pippin
(Name)

Salem Community
(Address)

(2) Location: SW 1/4, SW 1/4, Sec 17 T6 R15

7 miles East of Picayune
(distance) (direction) (Nearest town)

(3) Topography: Hilly
(Hilly) (Flat) (Level)

(4) Purpose of Well: Domestic
(Domestic Irrigation
Municipal, Industrial, Other)

Description & Color of Materials
Sand, Clay, Red Clay, Shell, etc.

Thick-
ness
Feet

Depth
Feet

Surface Clay 0 20

" sand 20 60

Blue Clay 60 170

good grey sand 170 205

Information upon completion of well:

(1) Diameter 2 inches.

(2) Total Depth 205 feet.

(3) Water Level 10 feet below top of ground.

(4) Cased to 200, Size 2"

(5) Screen: Size 2", Length 5'


(6) Were any formations sealed against pollution?

yes, no.

If YES depth of formation _____

Why _____

Drillers Remarks: _____

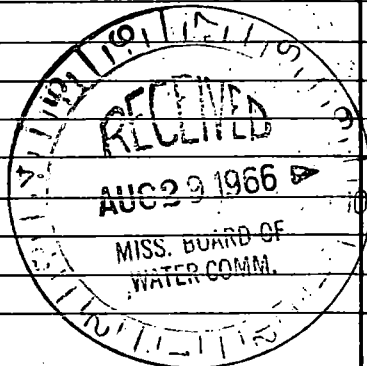

(Use Back Side)

Well No.

