

Walter Penton

HANCOCK
C 2018
7-67

MISSISSIPPI
BOARD OF WATER COMMISSIONERS
416 North State Street
Jackson, Mississippi 39201

WATER WELL DRILLERS LOG

7-8 1967 Penton Well Serv Hancock
 date well completed firm name county well located

LANDOWNER: Mrs Roger Lee
 Rt. 3 Box 291
 Pacyune MISS
 (mailing address)

description of formations encountered	from	to
Red Clay	0	30
" SAND	30	55
SAND	55	78
Blue Clay	78	207
Grey SAND	207	237

WELL LOCATION:
 sec. 8 T. 6 S. R. 15 W.
 9 miles East of Pacyune
 (distance) (direction) (nearest town)

WELL PURPOSE: Home
 (home, irrigation, municipal, industrial)

WELL COMPLETION DATA:

(1) diameter (inches) 4 1/2 Drilled

(2) total depth (feet) 237

(3) static water level (feet) 67 below top of ground.

(4) casing Galv. steel 232
 (material) (depth)

If telescope see back.
 (size)

(5) screen 5' 232
 (length) (depth to top)

012 2" S-Steel
 (size) (material)


(6) pump 1/2 H
 (HP) (yield gpm)

Elec
 (type power)

(7) electric log NO
 (yes or no)

(organization running log)

(8) how well bottom plugged B.W. Valve

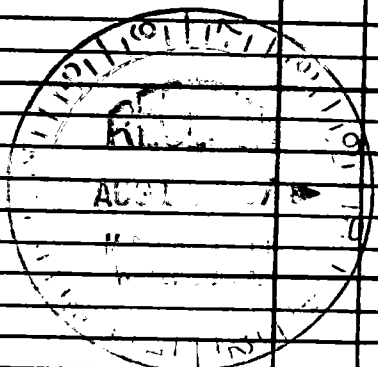

DRILLERS REMARKS:

