

Hancock
C 2019
7-67

MISSISSIPPI
BOARD OF WATER COMMISSIONERS
416 North State Street
Jackson, Mississippi 39201

WATER WELL DRILLERS LOG

7-14 1967 Penion Well Serv Hancock
date well completed firm name county well located

LANDOWNER: Johnny C Varnado

Rt. 3, Box 230

Picayune Miss.
(mailing address)

WELL LOCATION:

sec. 32 T R 6 S R 15 W
10 miles N. E. of Picayune
(distance) (direction) (nearest town)

WELL PURPOSE: Home
(home, irrigation, municipal, industrial)

WELL COMPLETION DATA:

(1) diameter (inches) 4 1/2" Drilled

(2) total depth (feet) 237

(3) static water level (feet) 62 below top of ground.

(4) casing Galv. steel 232
(material) (depth)

✓
(size) if telescope see back.

(5) screen 5' 232
(length) (depth to top)

012 2" S. Steel
(size) (material)

(6) pump 1 6
(HP) (yield gpm)

Elec
(type power)

(7) electric log NO
(yes or no)


(organization running log)

(8) how well bottom plugged BW Valve

description of formations encountered

from to

Red clay	0	20
" sand	20	63
White clay	63	80
Blue clay	80	204
Grey sand	204	237

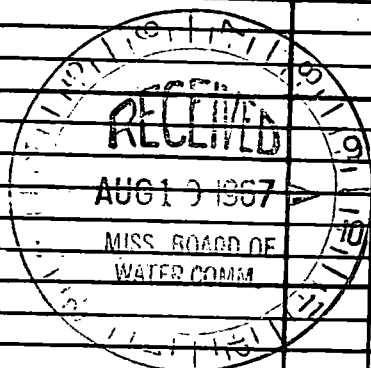

DRILLERS REMARKS:

If well telescopes please sketch and show depths.

GROUND LEVEL

		X	

SECTION 30

Please indicate well location X.

ADDITIONAL INFORMATION

If more than one screen, show locations of each on sketch.