

**MISSISSIPPI
BOARD OF WATER COMMISSIONERS**
416 North State Street
Jackson, Mississippi 39201

WATER WELL DRILLERS LOG

Neil Lumpkin Well Dlg Service, Hancock
~~Mr. P. Zimmerman~~

Hancock
C 7020
7-67

7-15-67 19 *1967* date well completed firm name county well located

LANDOWNER: *M.P. Zimmerman*
mark
P.O. Box 1183
Chalmette, La. 70043
(mailing address)

description of formations encountered	from	to
<i>surface clay</i>	<i>0</i>	<i>10</i>
<i>" sand</i>	<i>10</i>	<i>60</i>
<i>Blue clay</i>	<i>60</i>	<i>200</i>
<i>good sand</i>	<i>200</i>	<i>290</i>
<i>Blue clay</i>	<i>290</i>	<i>500</i>
<i>good sand</i>	<i>500</i>	<i>610</i>
<i>blue clay</i>	<i>610</i>	<i>930</i>
<i>good sand</i>	<i>930</i>	<i>990</i>
<i>blue clay</i>	<i>990</i>	<i>1100</i>
<i>good sand</i>	<i>1100</i>	<i>1178</i>

WELL LOCATION:
sec. T N R E S
12 miles *E.* of *Bayou*
(distance) (direction) (nearest town)

WELL PURPOSE: *home*
(home, irrigation, municipal, industrial)

WELL COMPLETION DATA:

(1) diameter (inches) *2*

(2) total depth (feet) *1178*

(3) static water level (feet) *12* below above
top of ground.

(4) casing *4 1/2" pipe 1157'*
(material) (depth)
2 if telescope see back.
(size)


(5) screen *21'*
(length) (depth to top)
2" *Stainless Steel*
(size) (material)

(6) pump (HP) (yield gpm)
 (type power)

(7) electric log *no*
(yes or no)
 (organization running log)


(8) how well bottom plugged *Johnson back*
pressure valve

DRILLERS REMARKS: *good well for that locality Full pipe.*

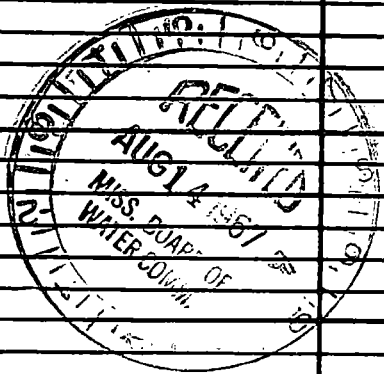

If well telescopes please sketch and show depths.

GROUND LEVEL

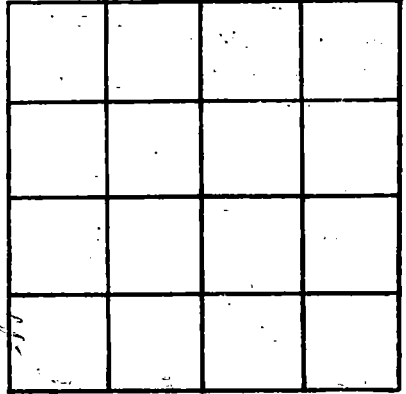

SECTION _____

Please indicate well location X.

ADDITIONAL INFORMATION

If more than one screen, show locations of each on sketch.