

HANCOCK

C 2081

3-68

MISSISSIPPI
 BOARD OF WATER COMMISSIONERS
 416 North State Street
 Jackson, Mississippi 39201

WATER WELL DRILLERS LOG

March 16, 1968 Neil Lumpkin Well Hancock
 date well completed firm name county well located

Drilling Service

LANDOWNER: W. J. Pippin

Picayune, Miss.

Route: Old Kiln Rd.
 (mailing address)

WELL LOCATION:


sec. 19 T. 6 S. R. 15 W.
10 miles EAST of Picayune
 (distance) (direction) (nearest town)

WELL PURPOSE: Industrial
 (home, irrigation, municipal, industrial)

WELL COMPLETION DATA:

- (1) diameter (inches) 2"
- (2) total depth (feet) 195
- (3) static water level (feet) 20 below top of ground.
- (4) casing galv., 189,
 (material) (depth)
2" if telescope see back.
 (size)
- (5) screen 5',
 (length) (depth to top)
2", St. Steel
 (size) (material)
- (6) SEARS 1/2 500 per hr.
 pump (HP) (yield gpm)
electric
 (type power)
- (7) electric log no.
 (yes or no)
 (organization running log)
- (8) how well bottom plugged Johnson
Back pressure valve

description of formations encountered	from	to
<u>surface clay</u>	<u>0</u>	<u>20</u>
<u>Sand</u>	<u>20</u>	<u>55</u>
<u>Blue Clay</u>	<u>55</u>	<u>160</u>
<u>Good Sand</u>	<u>160</u>	<u>195</u>

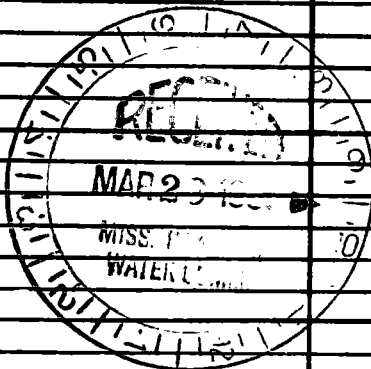

DRILLERS REMARKS:

If well telescopes please sketch and show depths.

GROUND LEVEL

X			

SECTION 19

Please indicate well location X.

ADDITIONAL INFORMATION

If more than one screen, show locations of each on sketch.