

HANCOCK

5 C 2022

5-68

MISSISSIPPI
 BOARD OF WATER COMMISSIONERS
 416 North State Street
 Jackson, Mississippi 39201

WATER WELL DRILLERS LOG

4-26

1968 Ponton well serv

Hancock

date well completed

firm name

county well located

LANDOWNER: Leo woods

Rt. 1, Box 296

Picayune MISS
(mailing address)

WELL LOCATION:

sec. 19 T-6 S R-15 W
 7 miles East of Picayune
 (distance) (direction) (nearest town)

WELL PURPOSE: Home
 (home, irrigation, municipal, industrial)

WELL COMPLETION DATA:

- (1) diameter (inches) 2"
- (2) total depth (feet) 370
- (3) static water level (feet) 13' below top of ground
- (4) casing Galv. steel 365' (material) (depth)
2" (size) if telescope see back.
- (5) screen 5' 365' (length) (depth to top)
0.012 2" S. steel (size) (material)
- (6) pump 1/2 10 (HP) (yield gpm)
Elec (type power)
- (7) electric log NO (yes or no)

(organization running log)

(8) how well bottom plugged B.W. Valve

DRILLERS REMARKS:

description of formations encountered


from

to

Red clay	0	38
Sand	38	54
White clay	54	62
Brown clay	62	70
Blue clay	70	178
Mud	178	195
Blue clay	195	328
Grey sand	328	370

If well telescopes please sketch and show depths.

GROUND LEVEL

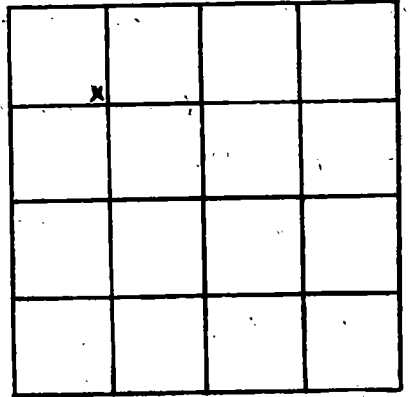

SECTION 19

Please indicate well location X.

ADDITIONAL INFORMATION

Lined area for additional information.

If more than one screen, show locations of each on sketch.